


NO.	DATE	DESCRIPTION
11/13/18	FOR REVIEW	


DATE: 11/13/18  
DRAWN BY: [ ]  
CHECKED BY: [ ]

**SHEET:**  
**AS1.1**

JOB NO. 18099

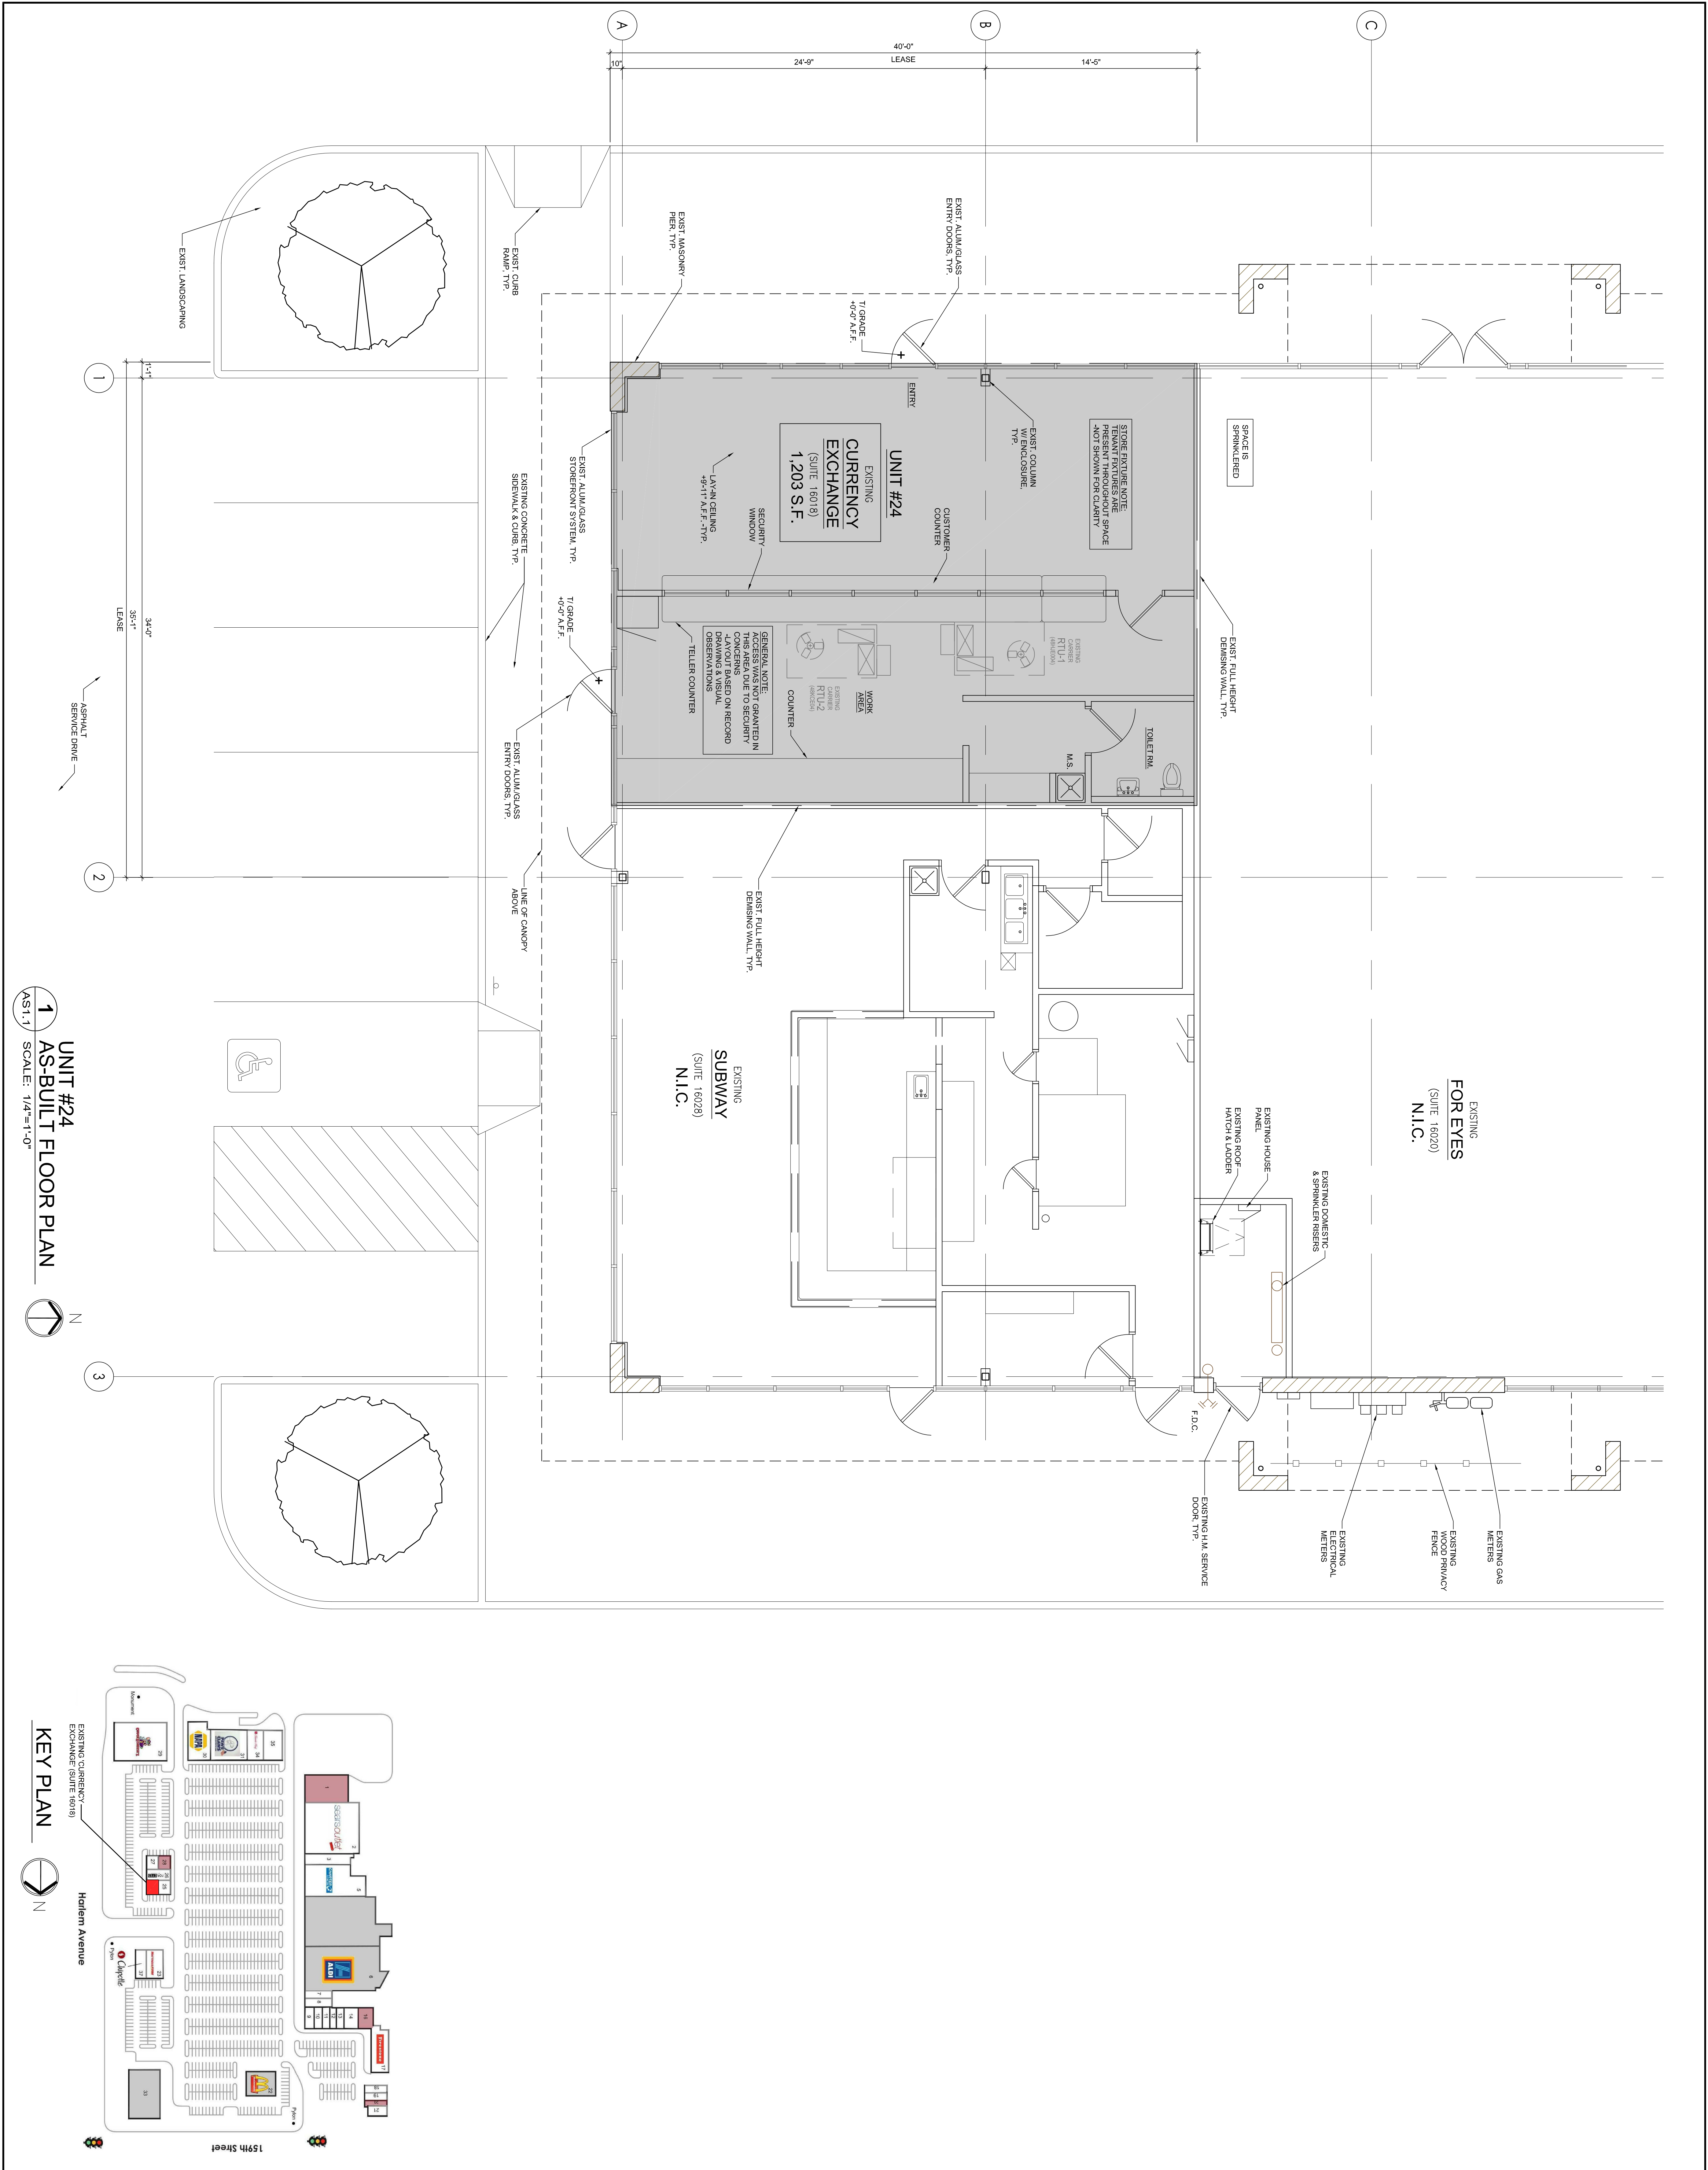

**UNIT #24 AS-BUILT FLOOR PLAN**  
SCALE: 1/4"=1'-0"  
AS1.1

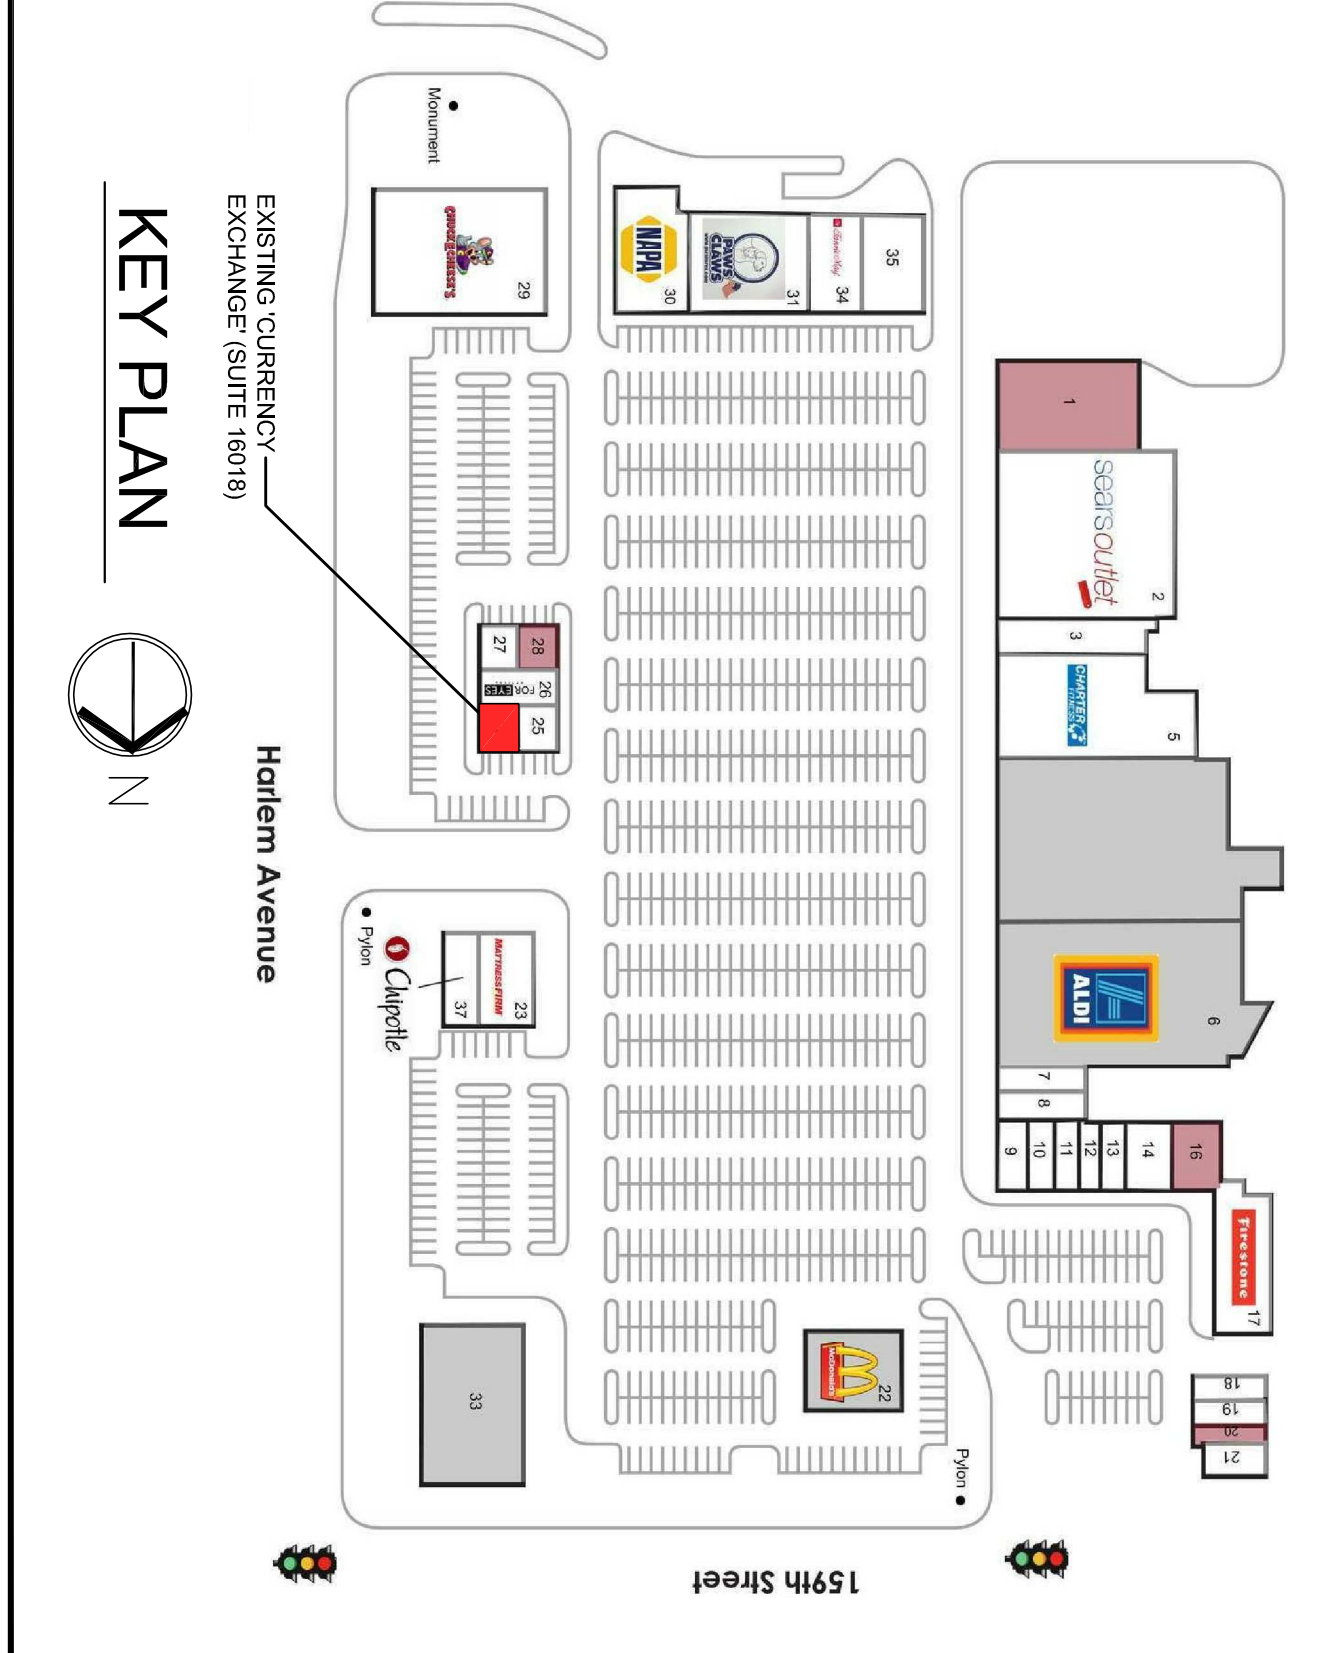

**KEY PLAN**