



PROJECT:

AS-BUILT
FLOOR PLANS
PARK CENTER
S/W CORNER OF
159th STREET &
HARTE AVENUE
TIMLEY PARK, IL

SHEET TITLE:
AS-BUILT
FLOOR PLAN


| NO. | DATE | DESCRIPTION |
|----------|------|-------------|
| 09/24/11 | | FOR REVIEW |
| | | |
| | | |
DESIGNER: PFC, INCORPORATED
ARCHITECT: PFC, INCORPORATED
ALL APPEARING HEREIN SHALL NOT BE SO
DUPLICATED, DISCLOSED OR OTHERWISE
WITHHOLDEN WITHOUT WRITTEN CONSENT.
DRAWN BY: CHECKED BY:

SHEET:

AS1.0

JOB NO. 18099

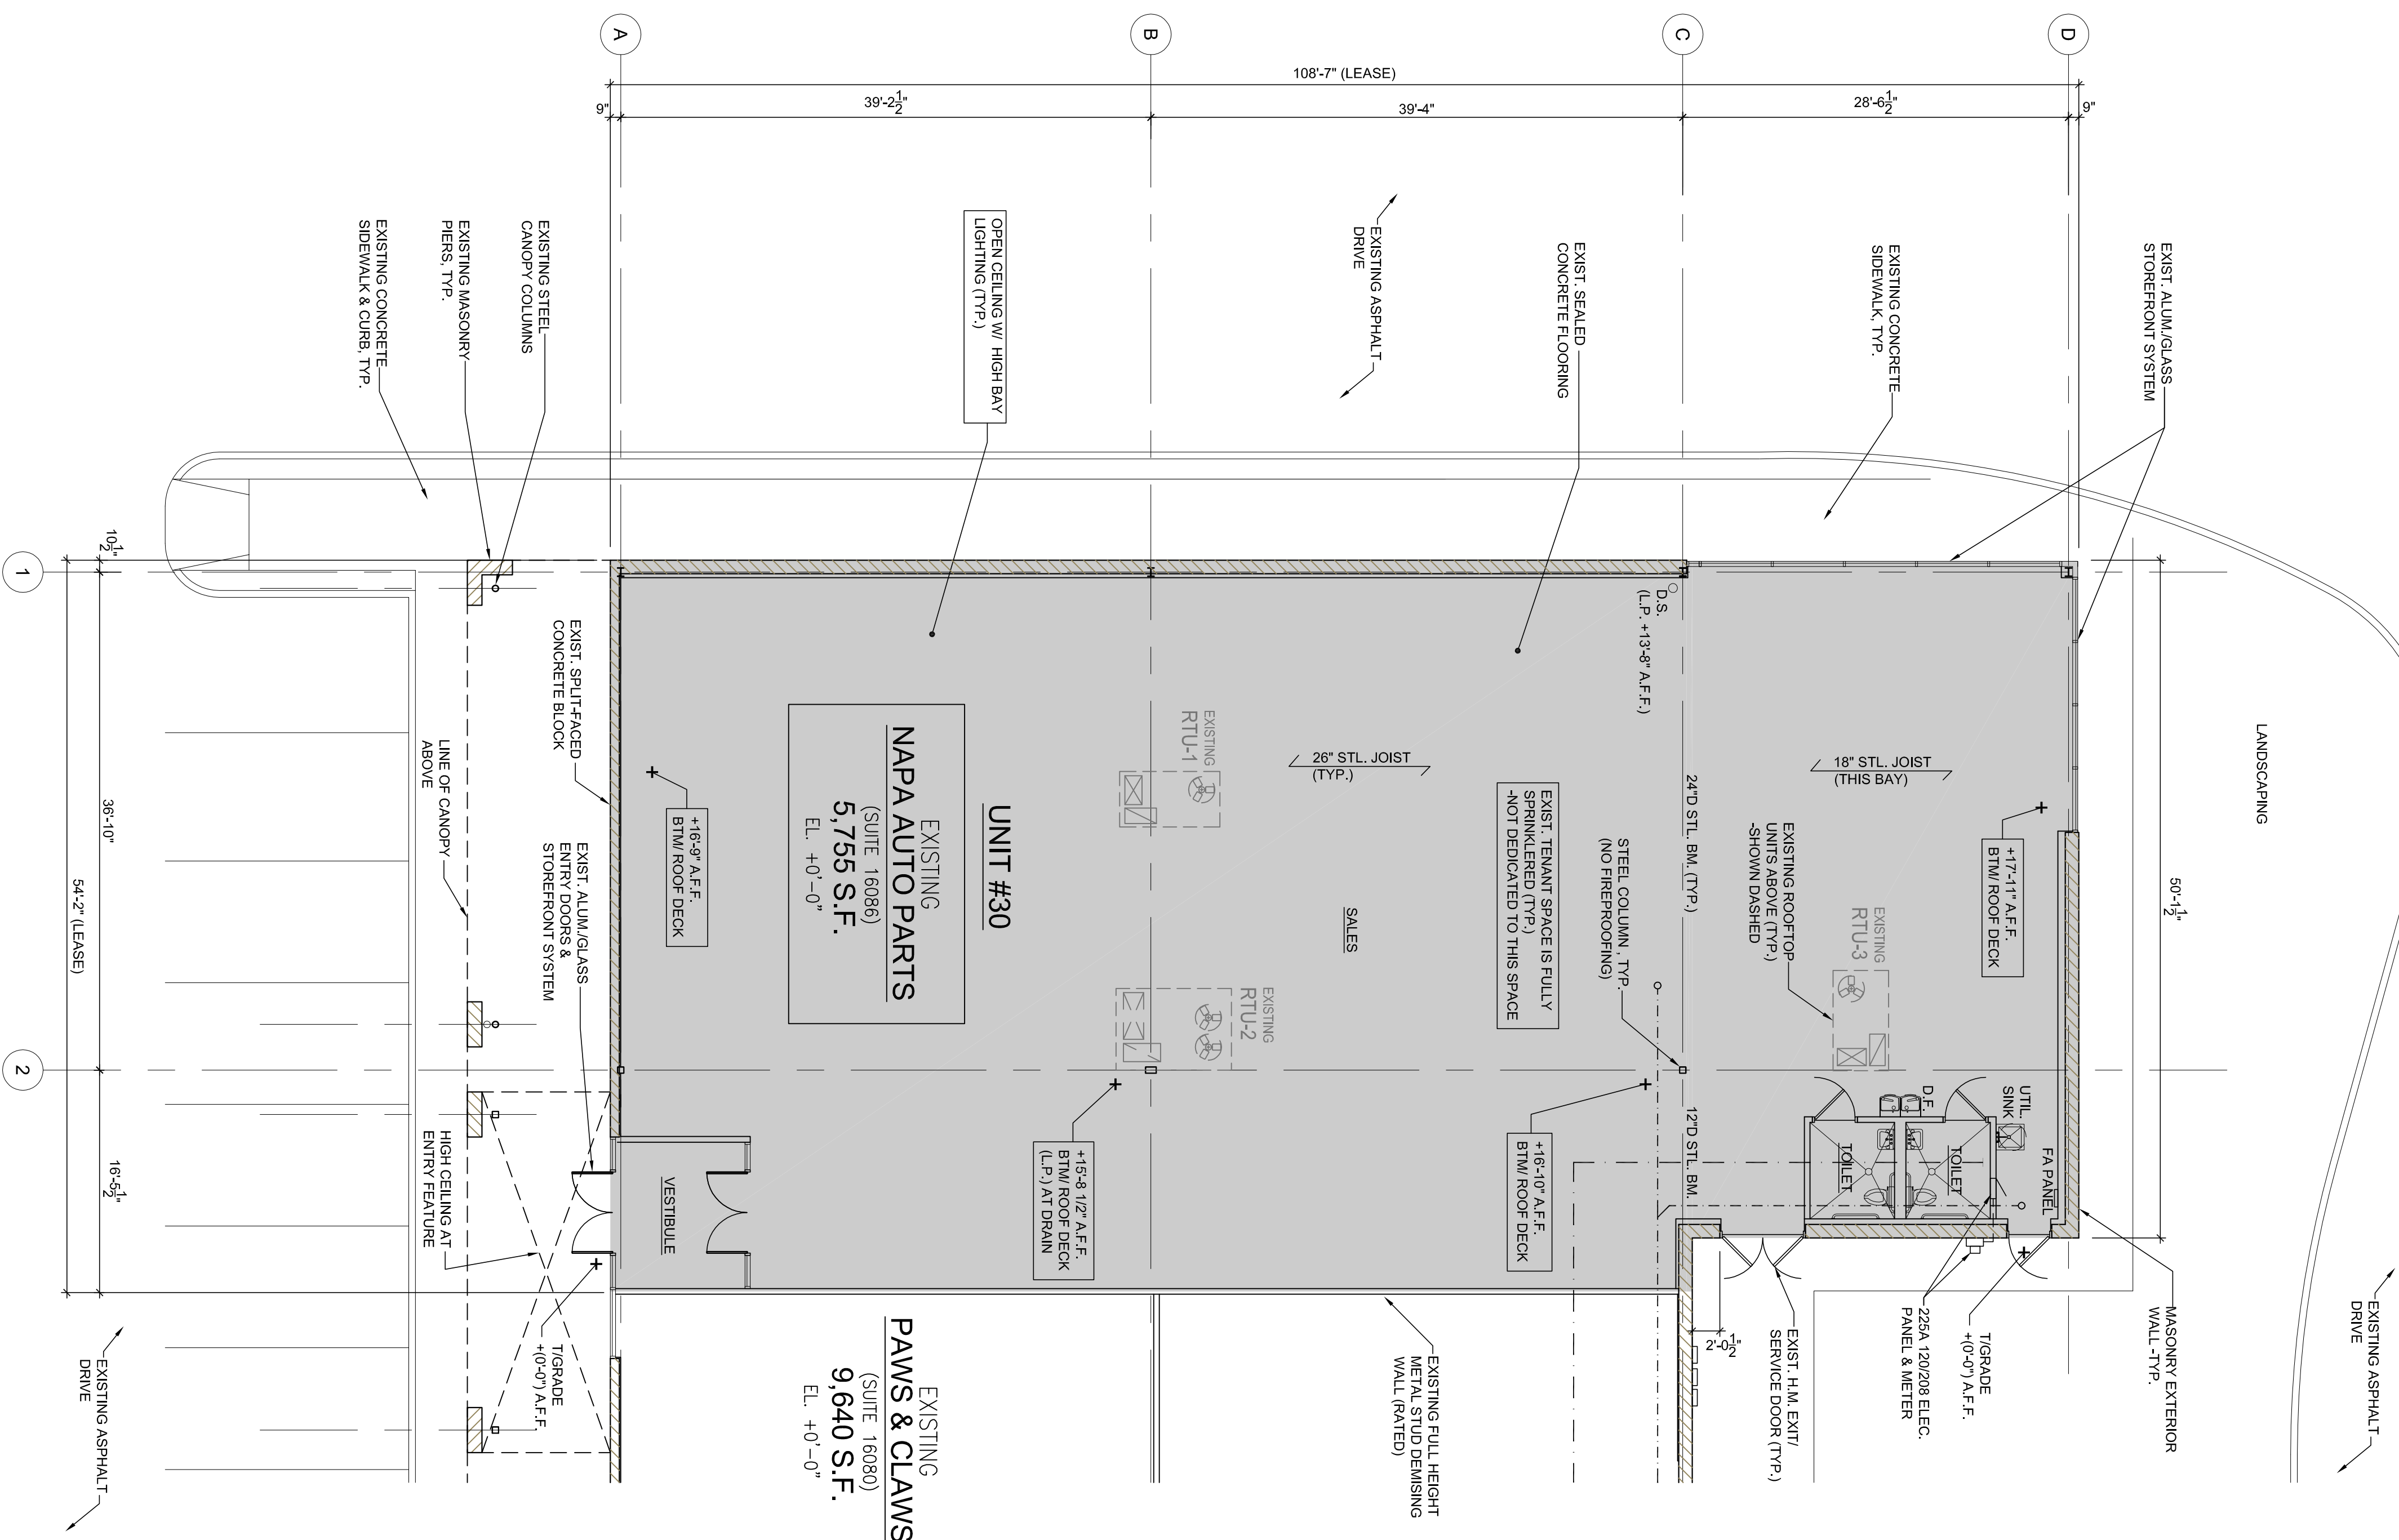

1 UNIT #30
AS-BUILT FLOOR PLAN
SCALE: 1/8"=1'-0"
AS1.0

