


NO.	DATE	DESCRIPTION
09/24/18		FOR REVIEW


**DEVELOPER:** PARK, INCORPORATED  
ALL APPEARING HEREIN SHALL NOT BE CONSIDERED AS A CONTRACT DOCUMENT UNLESS SPECIFICALLY IDENTIFIED AS SUCH.  
**DRAWN BY:** [Name]  
**CHECKED BY:** [Name]

**SHEET:**  
AS1.1


**JOB NO.:** 18099

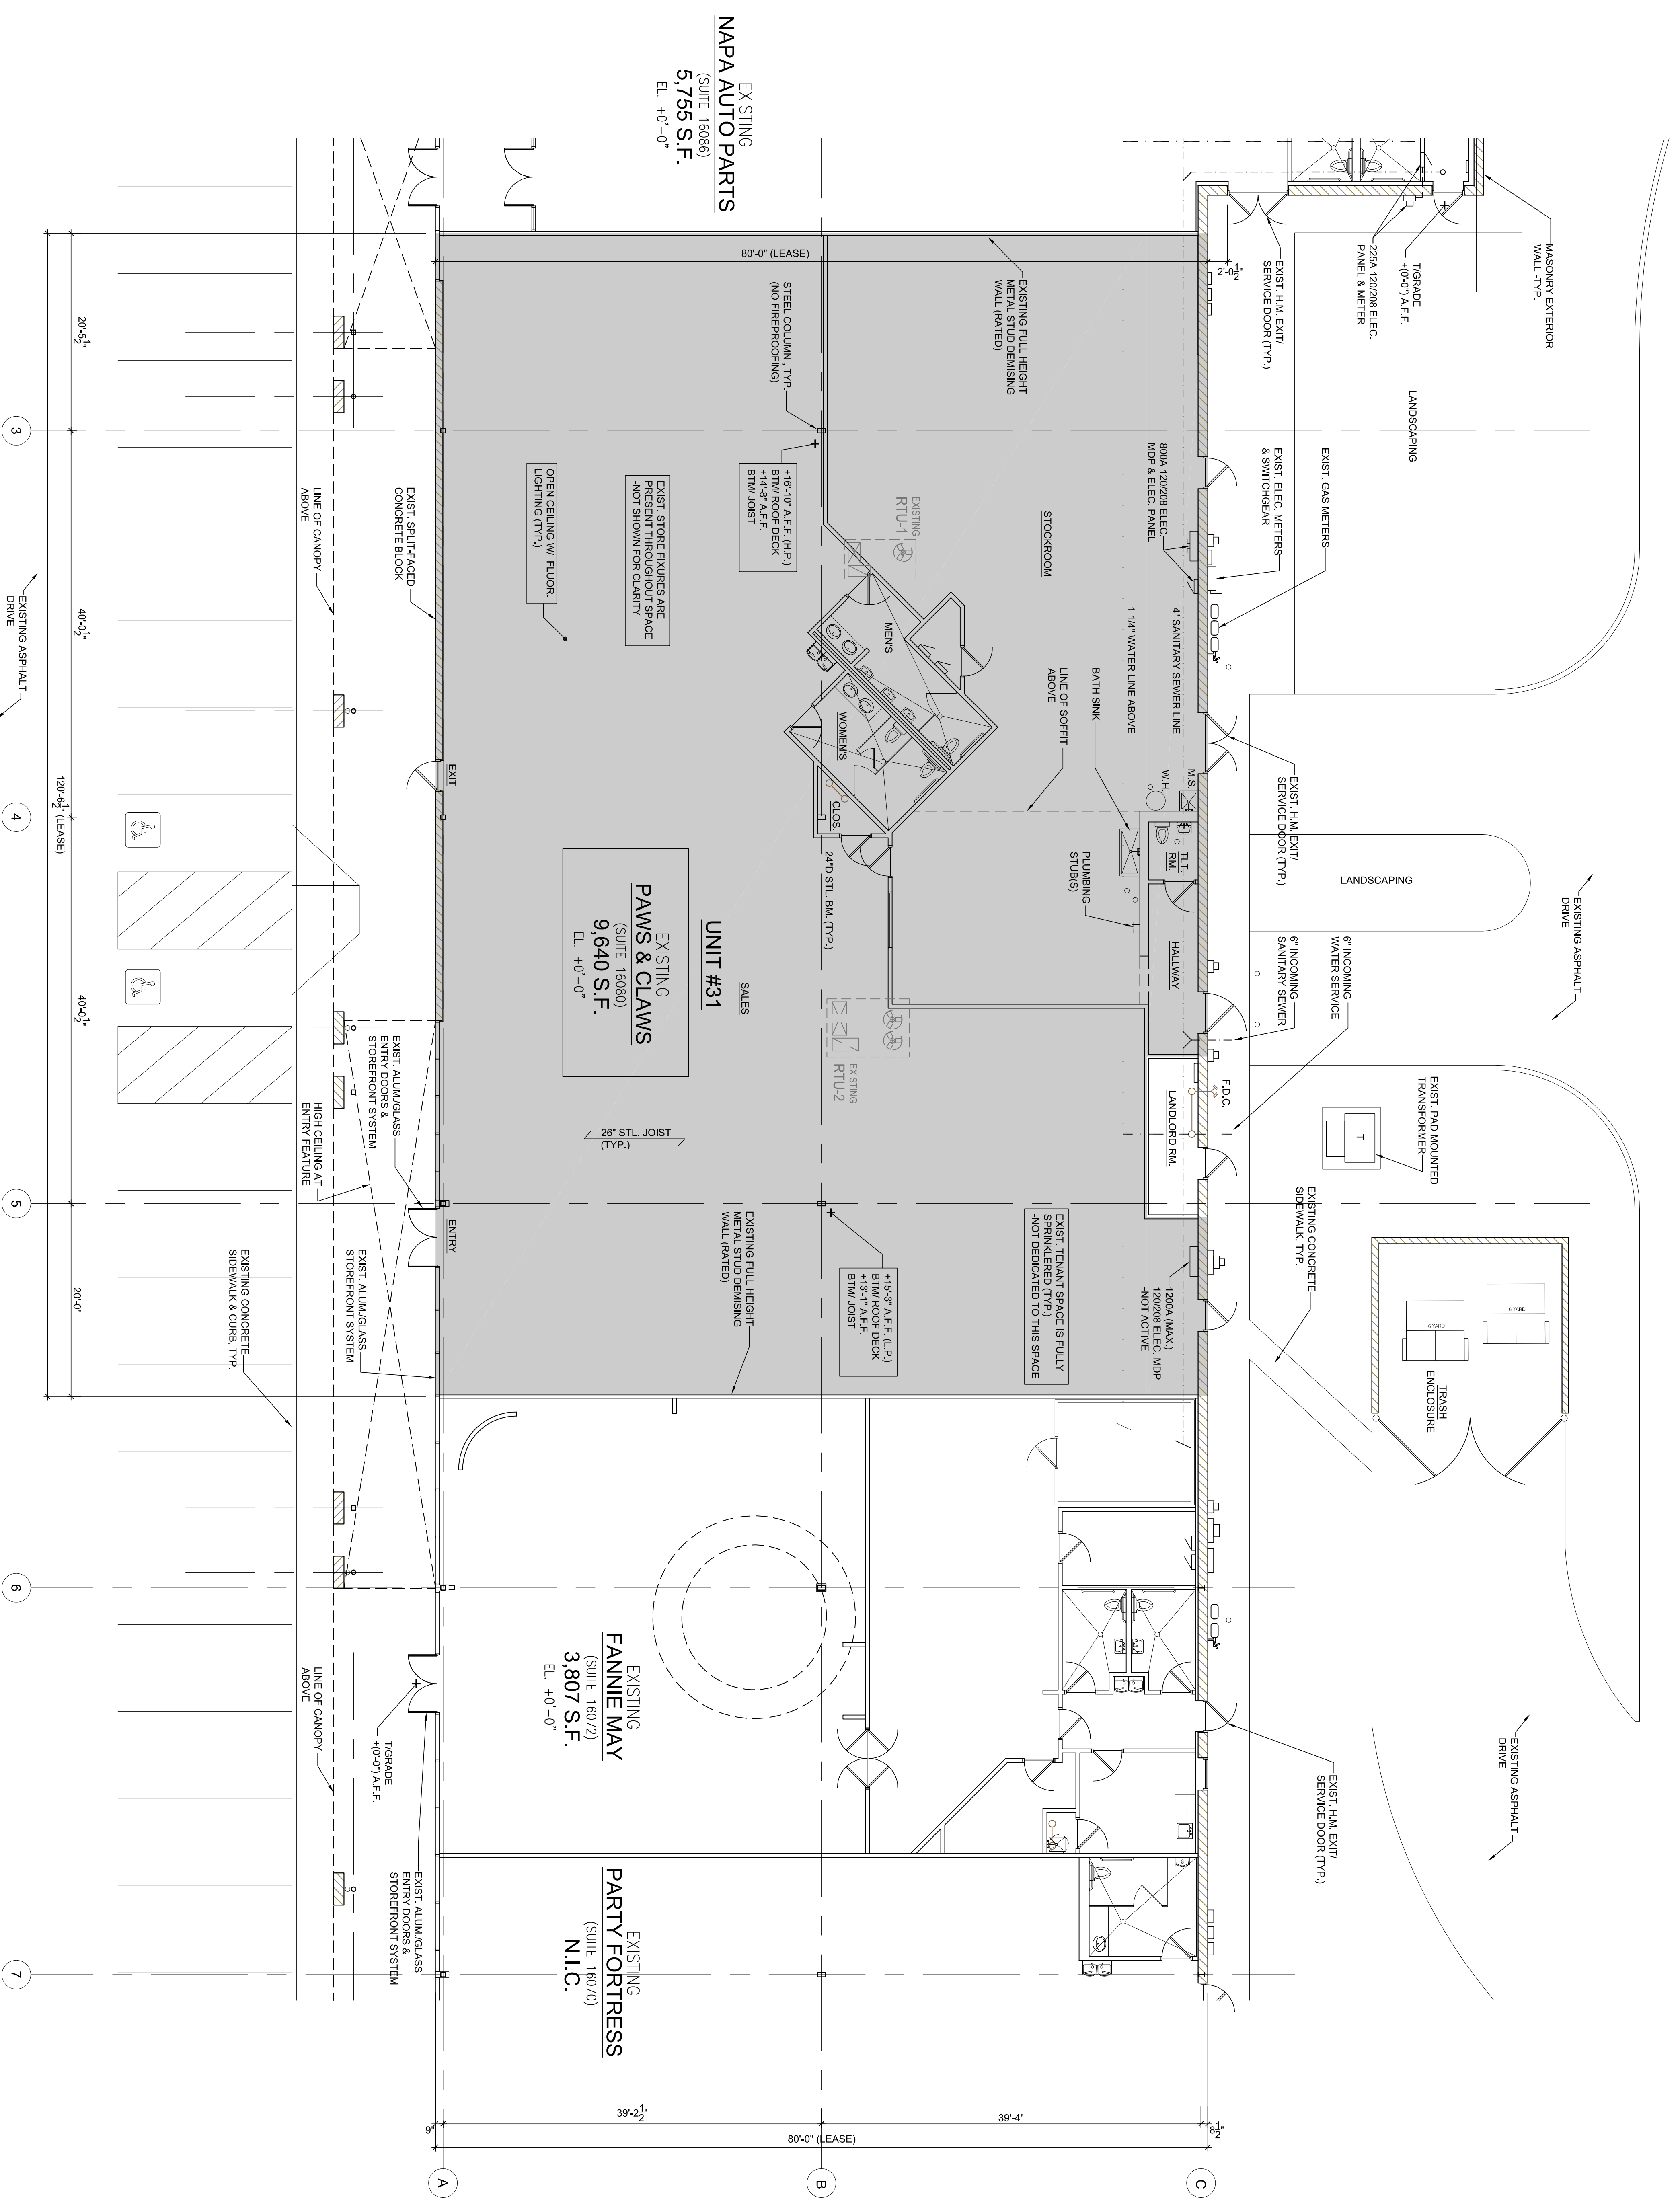

**1 UNIT #31 AS-BUILT FLOOR PLAN**  
SCALE: 1/8"=1'-0"

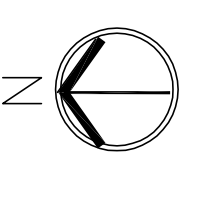

**KEY PLAN**

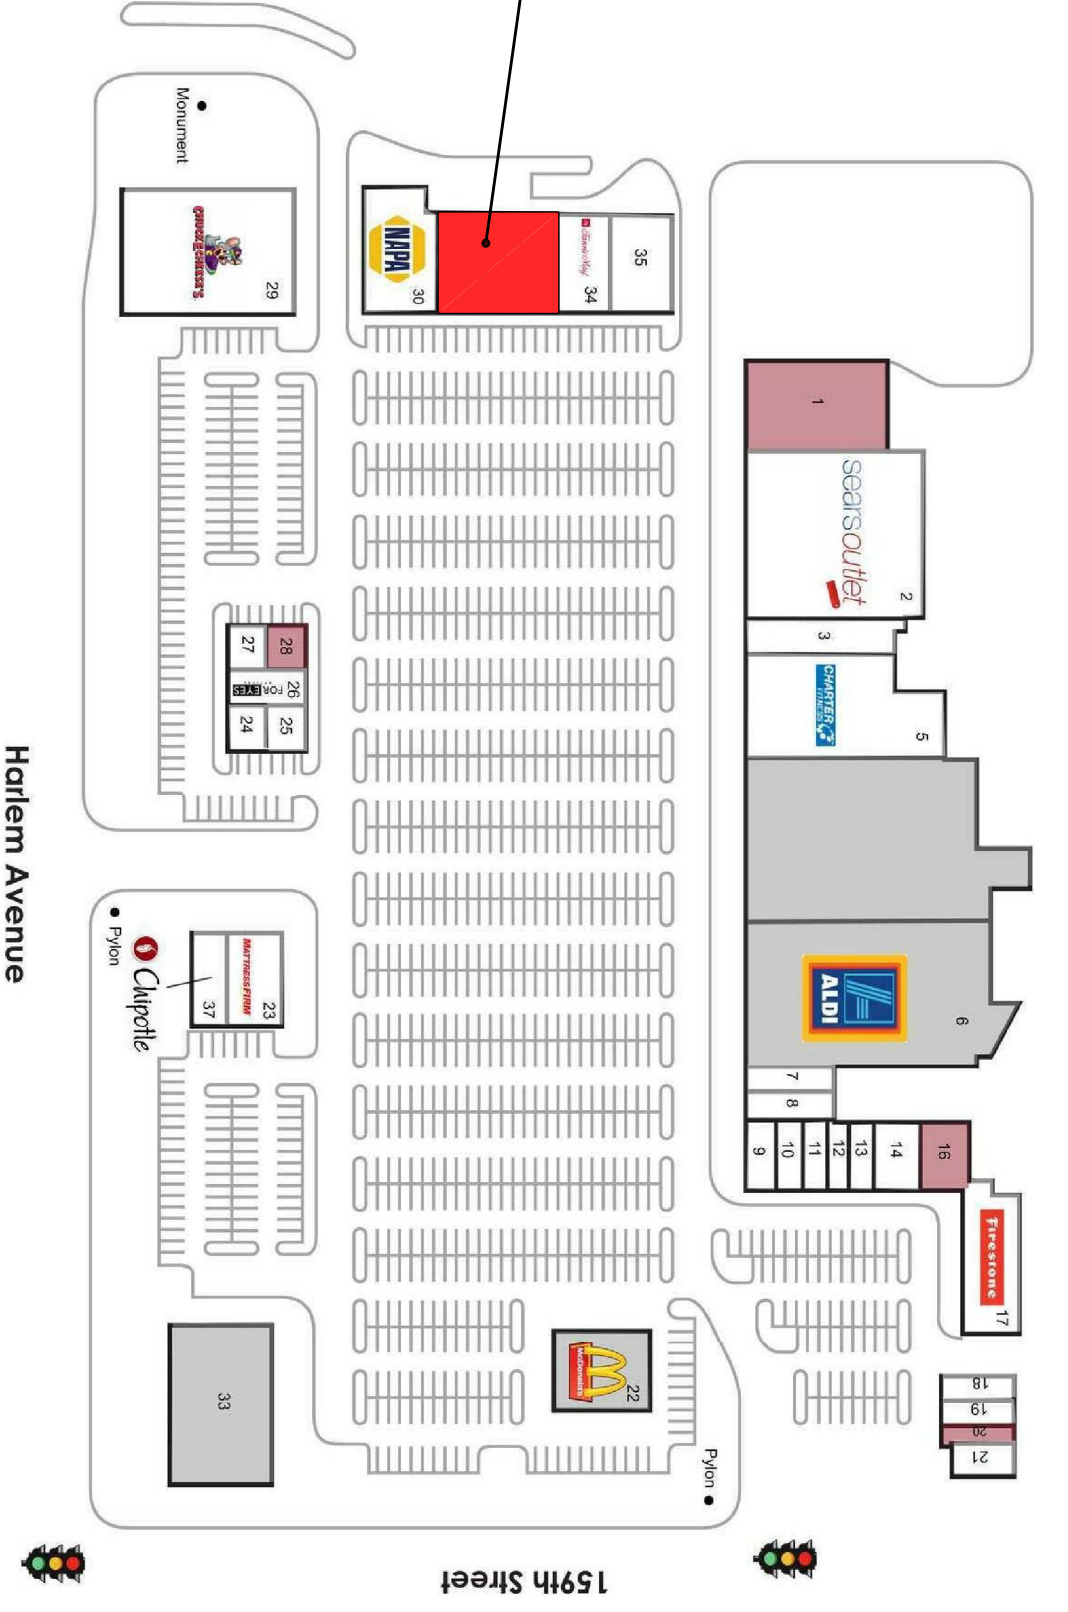

Holdem Avenue

159th Street