

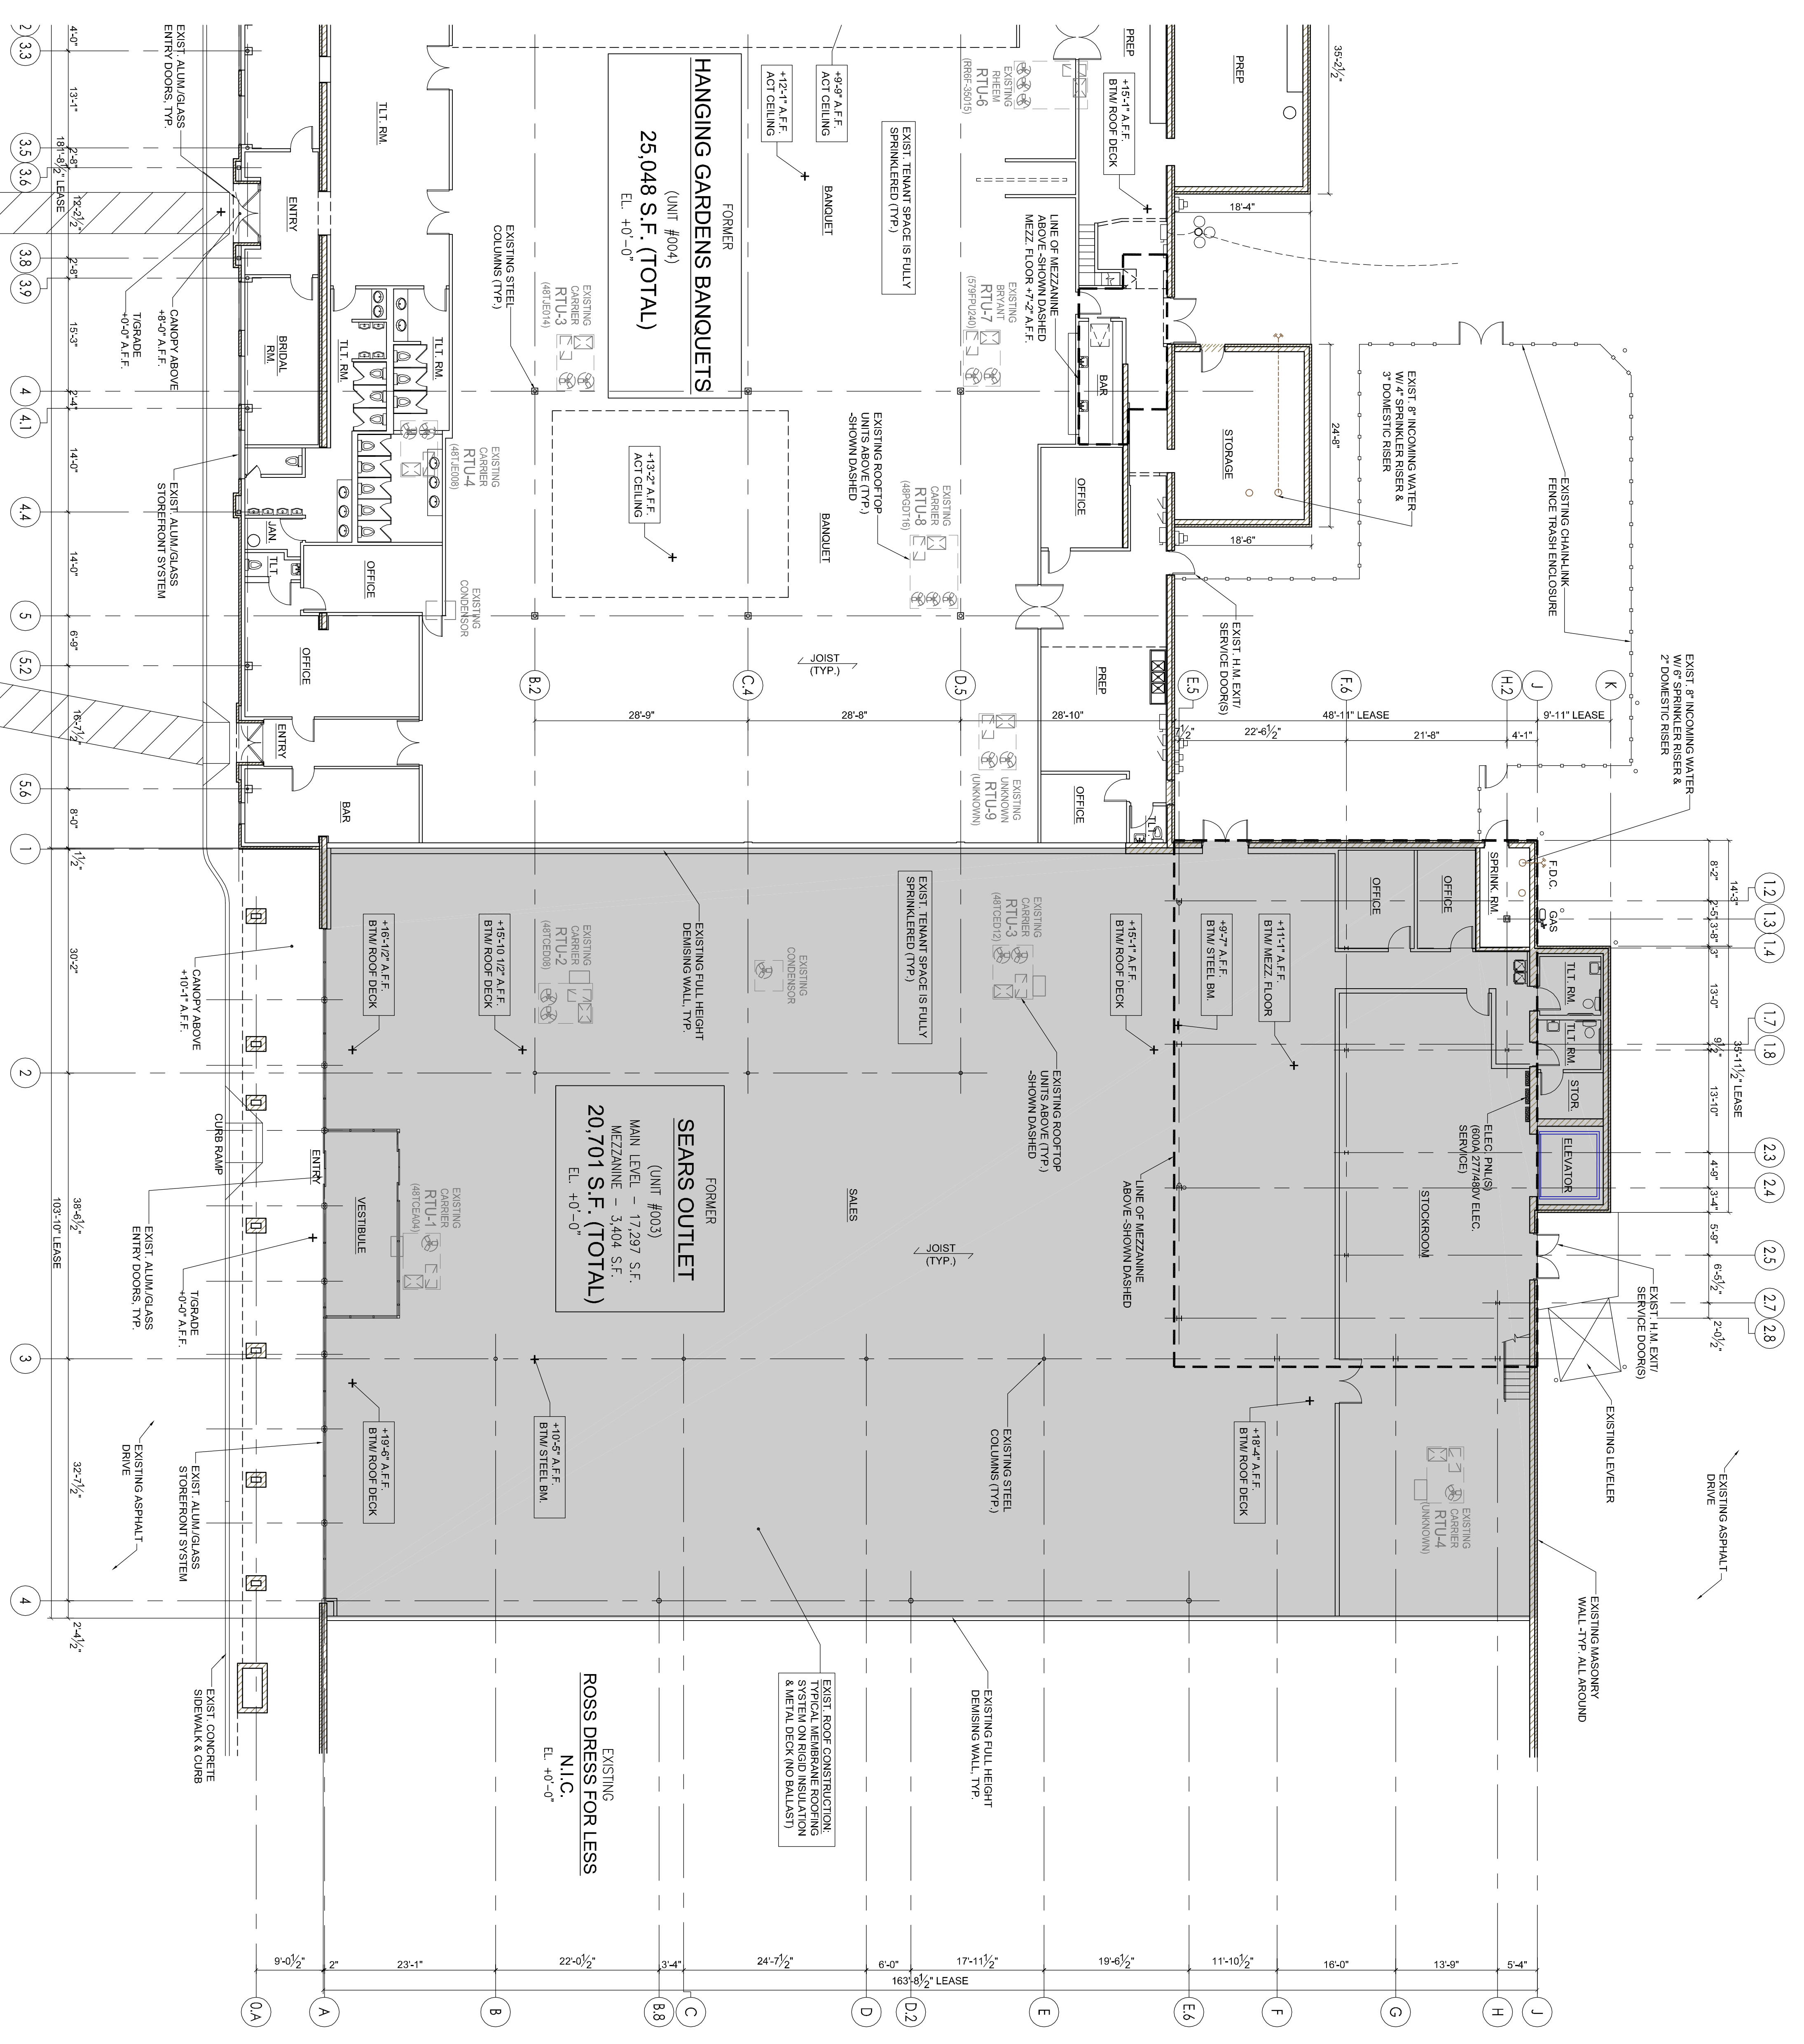
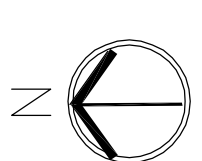


2 MEZZANINE PLAN
 AS1.0 SCALE: 3/32"=1'-0"

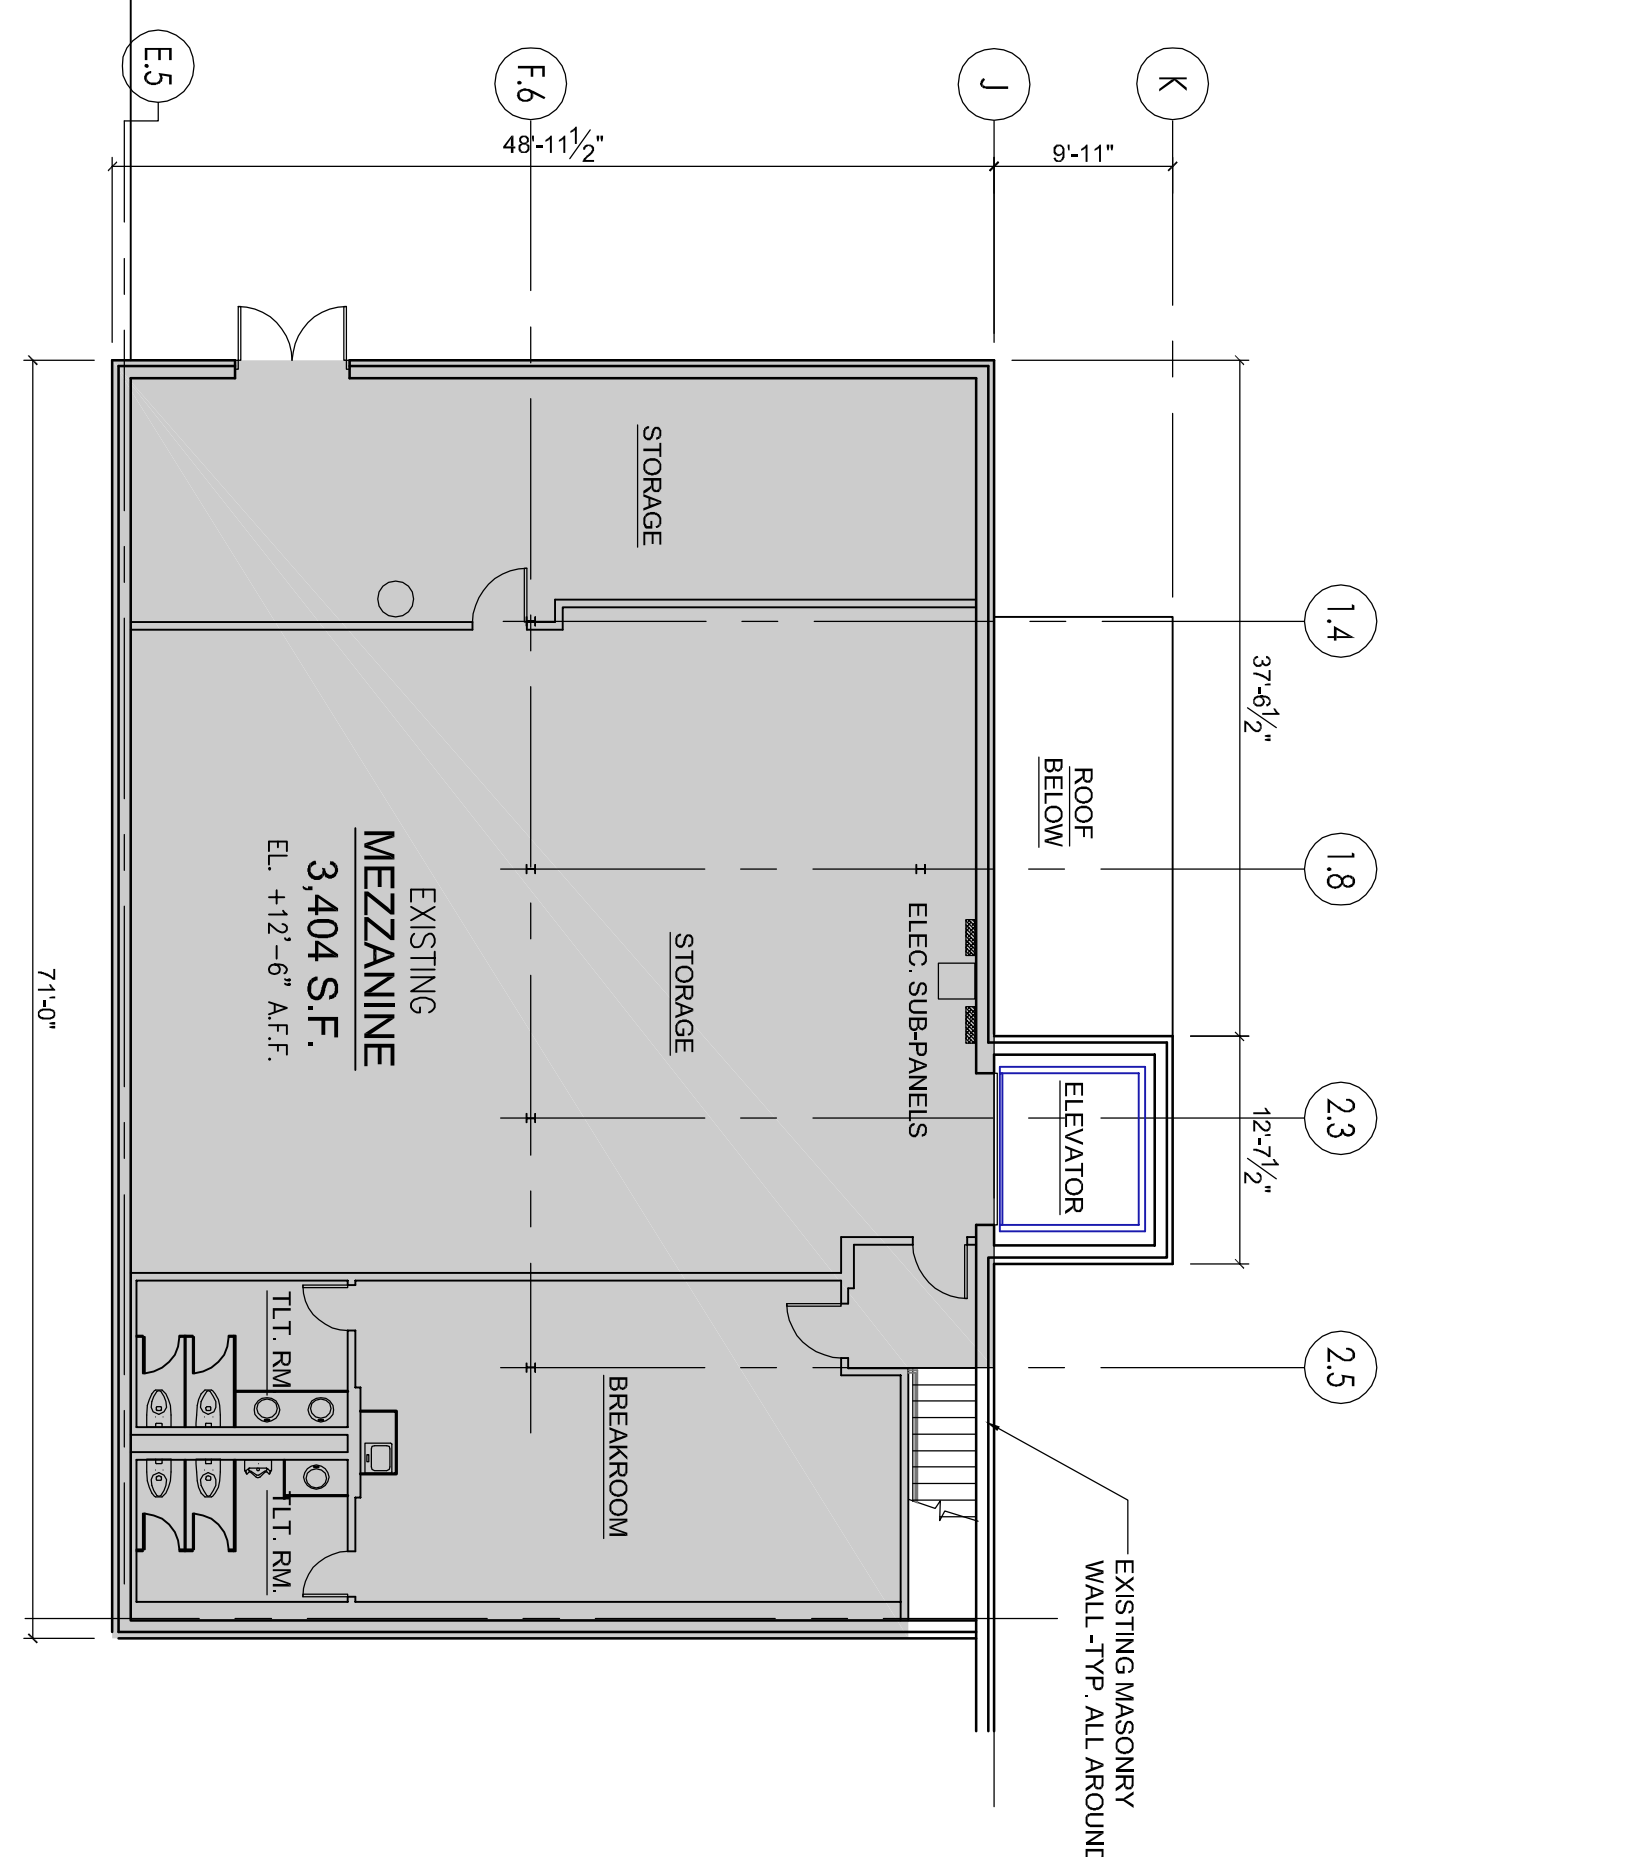

1 AS-BUILT FLOOR PLAN
 AS1.0 SCALE: 3/32"=1'-0"

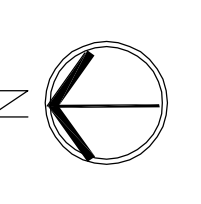

2803 BUTTERFIELD RD.
 SUITE 340
 OAK BROOK, IL 60523
 TEL: (312) 795-1245
 FAX: (312) 795-6123



OWNER:
 IRC
RETAIL CENTERS
 814 COMMERCE DRIVE
 SUITE 300
 OAK BROOK, IL 60523

PROJECT:
 LEASE PLAN
 THATCHER WOODS
 CENTER
 8301-8345 W. BELMONT AVE.
 RIVER GROVE, IL 60171

SHEET TITLE:
 AS-BUILT
 FLOOR PLAN

| NO. | DATE | DESCRIPTION |
|----------|------|-------------|
| 05.21.18 | | FOR REVIEW |

REVISIONS:
 ALL REVISIONS SHALL BE
 APPROVED BY THE ARCHITECT
 WITHOUT WRITTEN CONSENT.
 DRAWN BY: _____
 CHECKED BY: _____

SHEET:

AS1.0

JOB NO. 18047