



PROJECT:

AS-BUILT
FLOOR PLANS
PARK CENTER
SW CORNER OF
159TH STREET &
HARLEM AVENUE
TINLEY PARK, IL

SHEET TITLE:
AS-BUILT
FLOOR PLAN


NO.	DATE	DESCRIPTION
03.19.18	FOR REVIEW	

Copyright - PFDA, INCORPORATED
ALL DRAWINGS AND WRITTEN INFORMATION
HEREIN ARE THE PROPERTY OF PFDA, INC.
NO PART OF THIS DRAWING SHALL BE
REPRODUCED OR TRANSMITTED IN ANY
FORM OR BY ANY MEANS, WITHOUT
WRITTEN CONSENT.
DRAWN BY: _____
CHECKED BY: _____

SHEET:

AS1.0

JOB NO. 18025

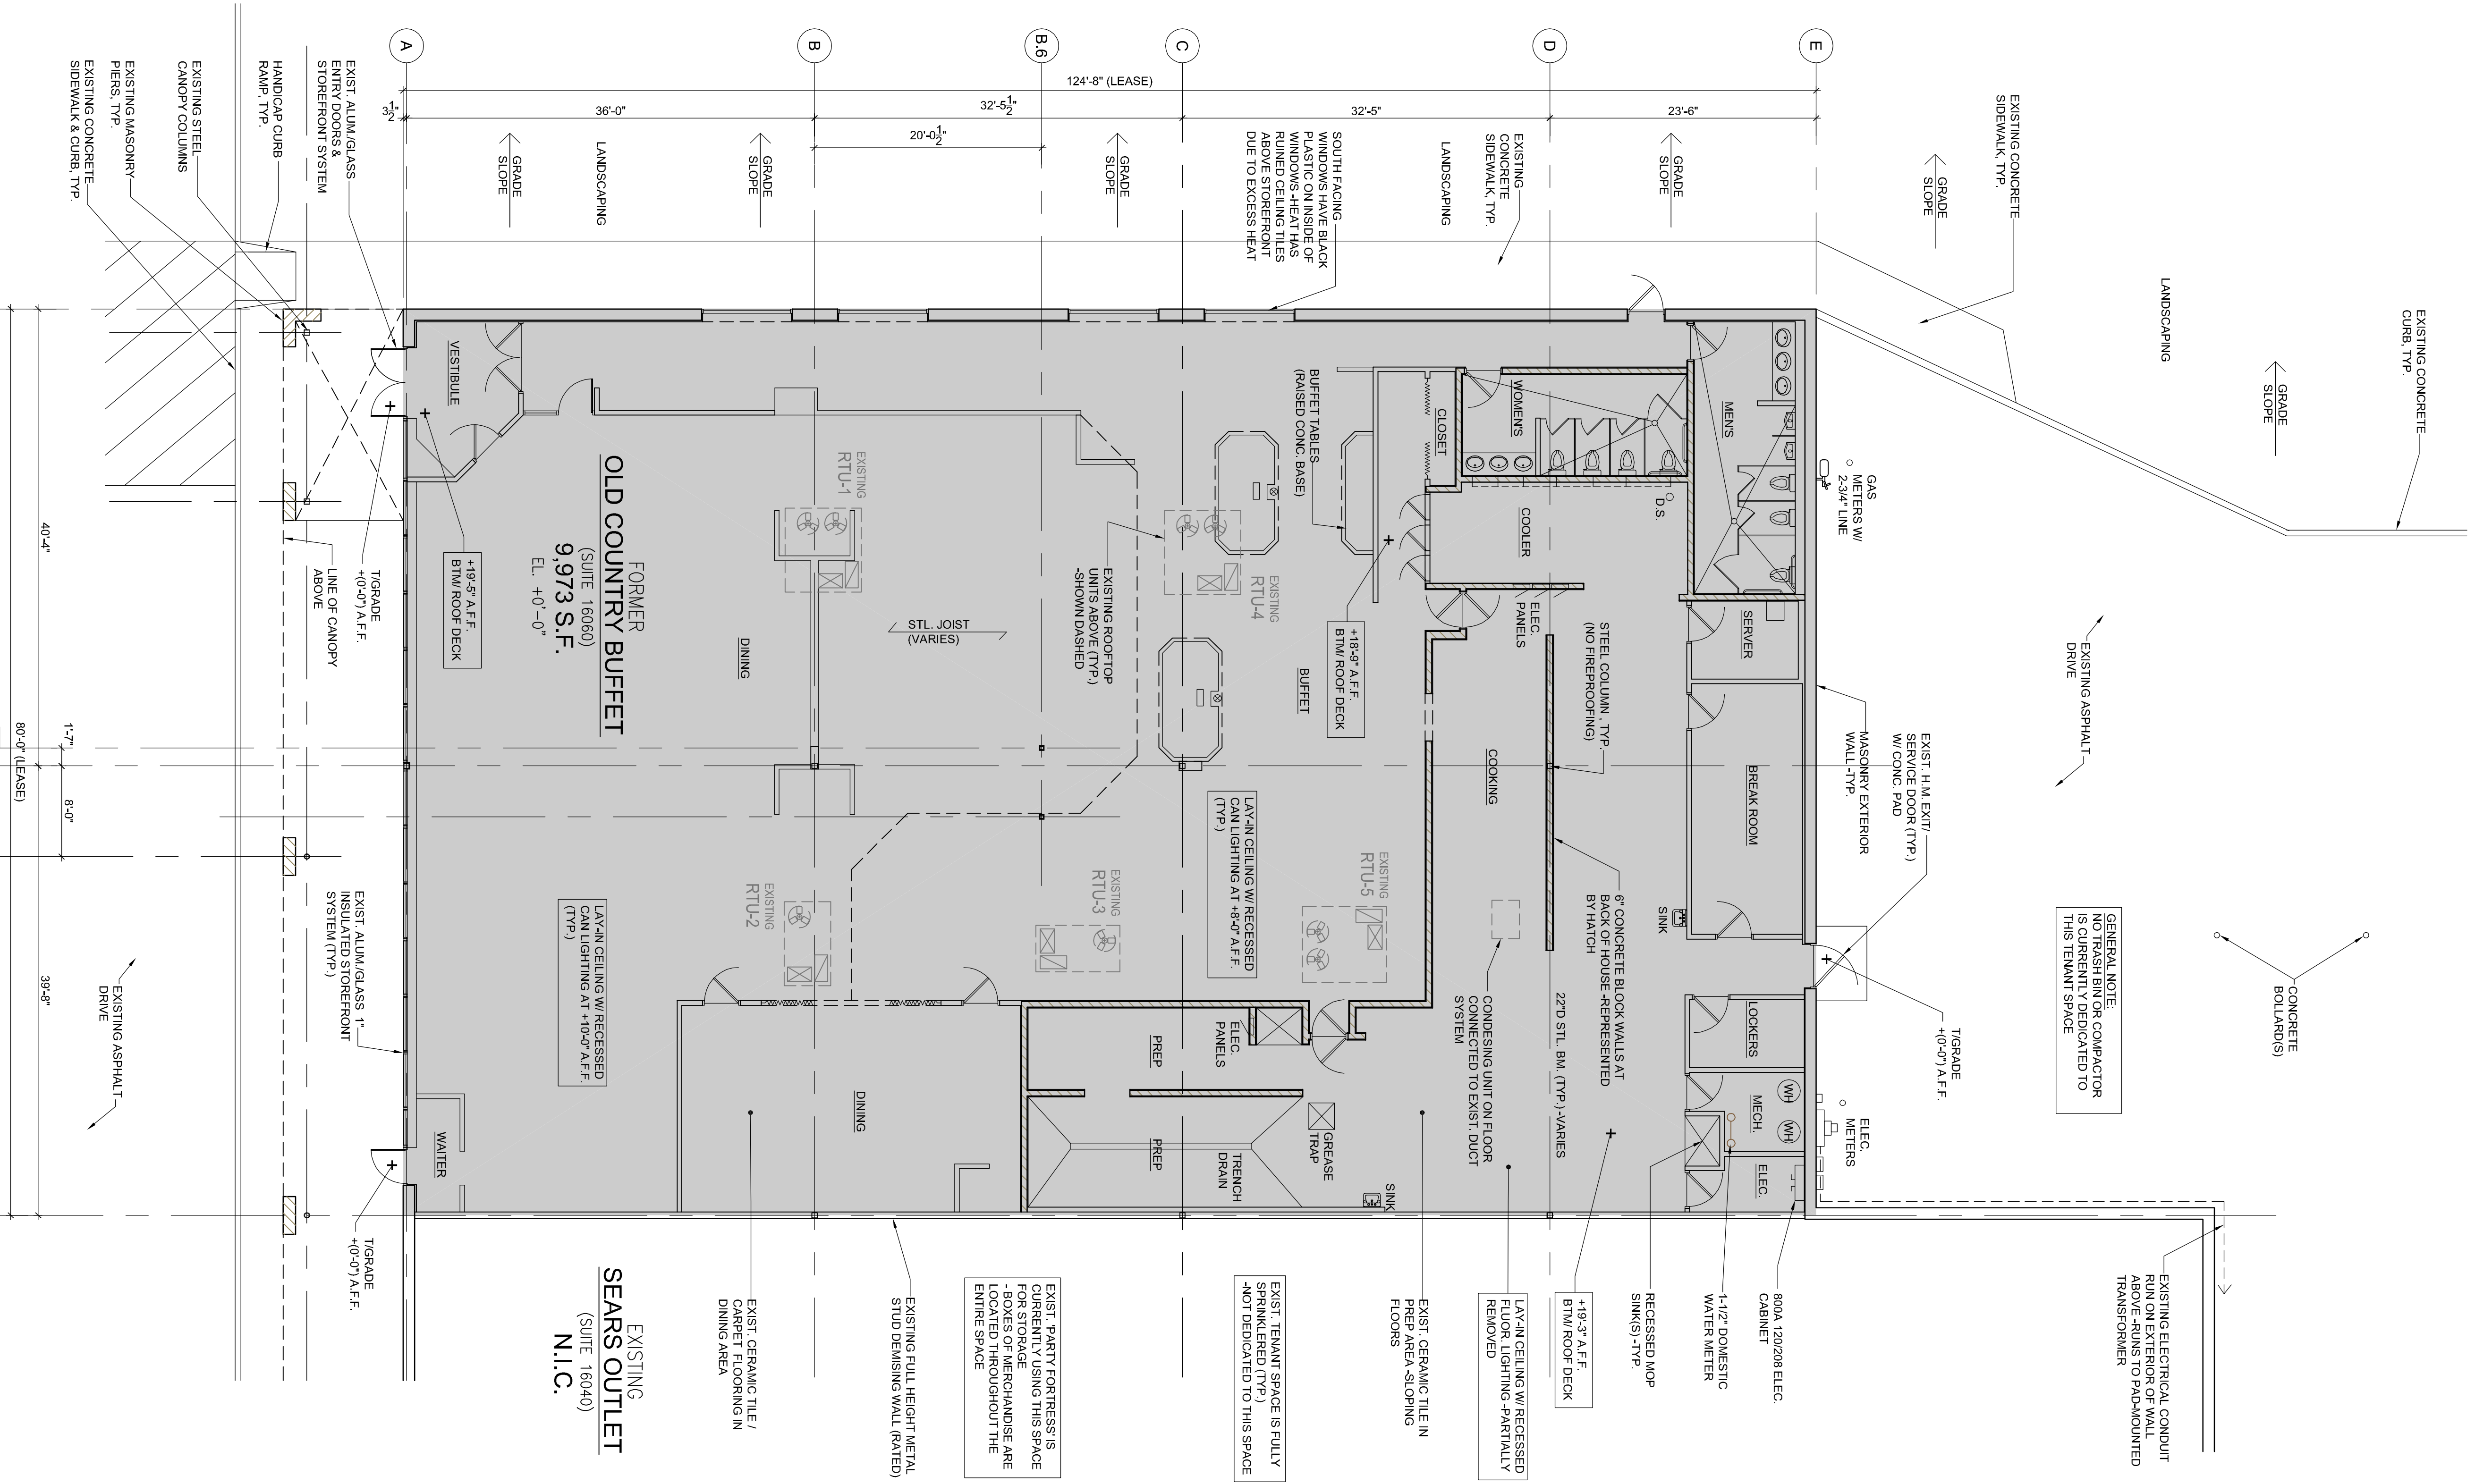

1 AS-BUILT FLOOR PLAN
SCALE: 1/8"=1'-0"
N

KEY PLAN
N

