


NO.	DATE	DESCRIPTION

05.10.18 FOR REVIEW  
**NO.** | **DATE** | **DESCRIPTION**

DRAWN BY: \_\_\_\_\_  
 CHECKED BY: \_\_\_\_\_

**SHEET:**  
  
**AS1.0**

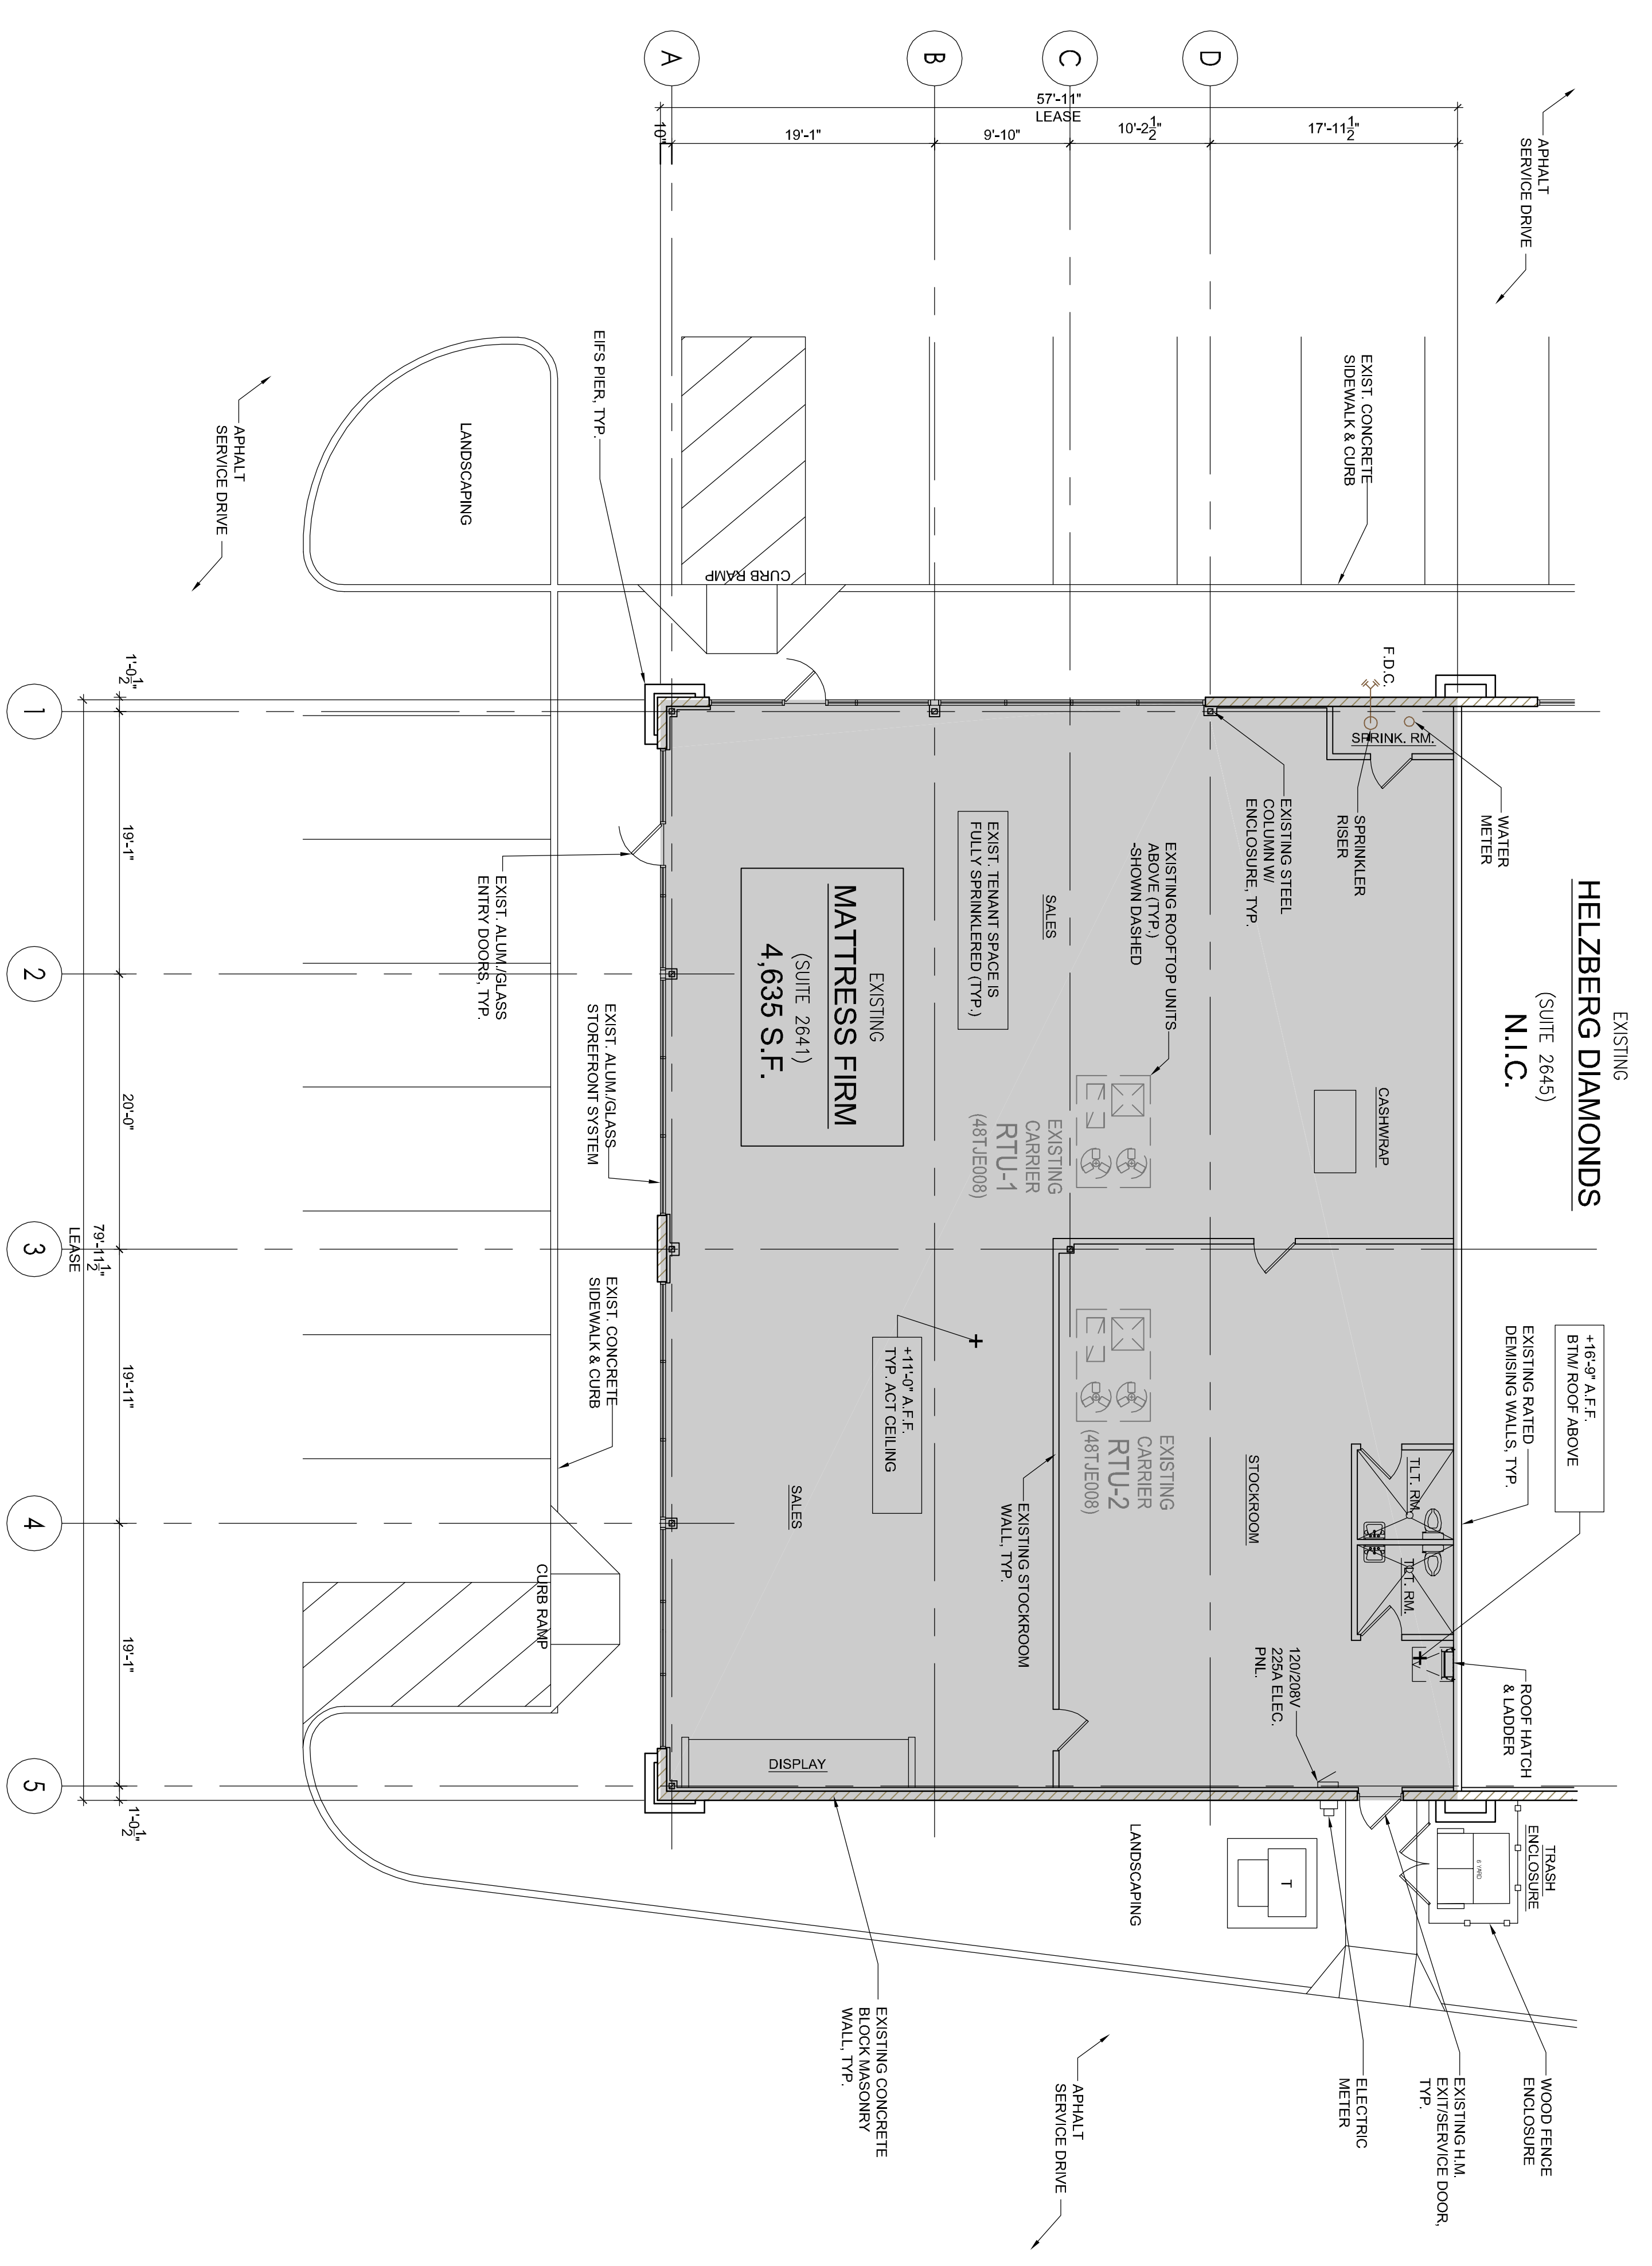

**1 AS-BUILT FLOOR PLAN**  
 SCALE: 1/8"=1'-0"

Copyright © PFDA, Incorporated  
 ALL DRAWING AND WRITTEN INFORMATION  
 HEREON IS THE PROPERTY OF PFDA  
 AND IS TO BE KEPT IN CONFIDENTIAL  
 AND WITHOUT WRITTEN CONSENT,  
 NO PART OF THIS DOCUMENT IS  
 TO BE REPRODUCED OR TRANSMITTED  
 IN ANY FORM OR BY ANY MEANS  
 ELECTRONIC OR MECHANICAL,  
 INCLUDING PHOTOCOPYING, RECORDING,  
 OR BY ANY INFORMATION STORAGE  
 AND RETRIEVAL SYSTEM.