

OWNER:



PROJECT:

SHEET TITLE:
AS-BUILT
FLOOR PLAN


NO.	DATE	DESCRIPTION
12.12.18	FOR REVIEW	

COPYRIGHT - PFDA, INCORPORATED
ALL DRAWING AND WRITTEN INFORMATION
HEREON BELONGS TO PFDA, INCORPORATED
AND SHALL REMAIN THE PROPERTY OF
PFDA, INCORPORATED. NO REUSE OR
REPRODUCTION IS PERMITTED
WITHOUT WRITTEN CONSENT.
DRAWN BY: _____ CHECKED BY: _____

SHEET:

AS1.0

JOB NO. 18134

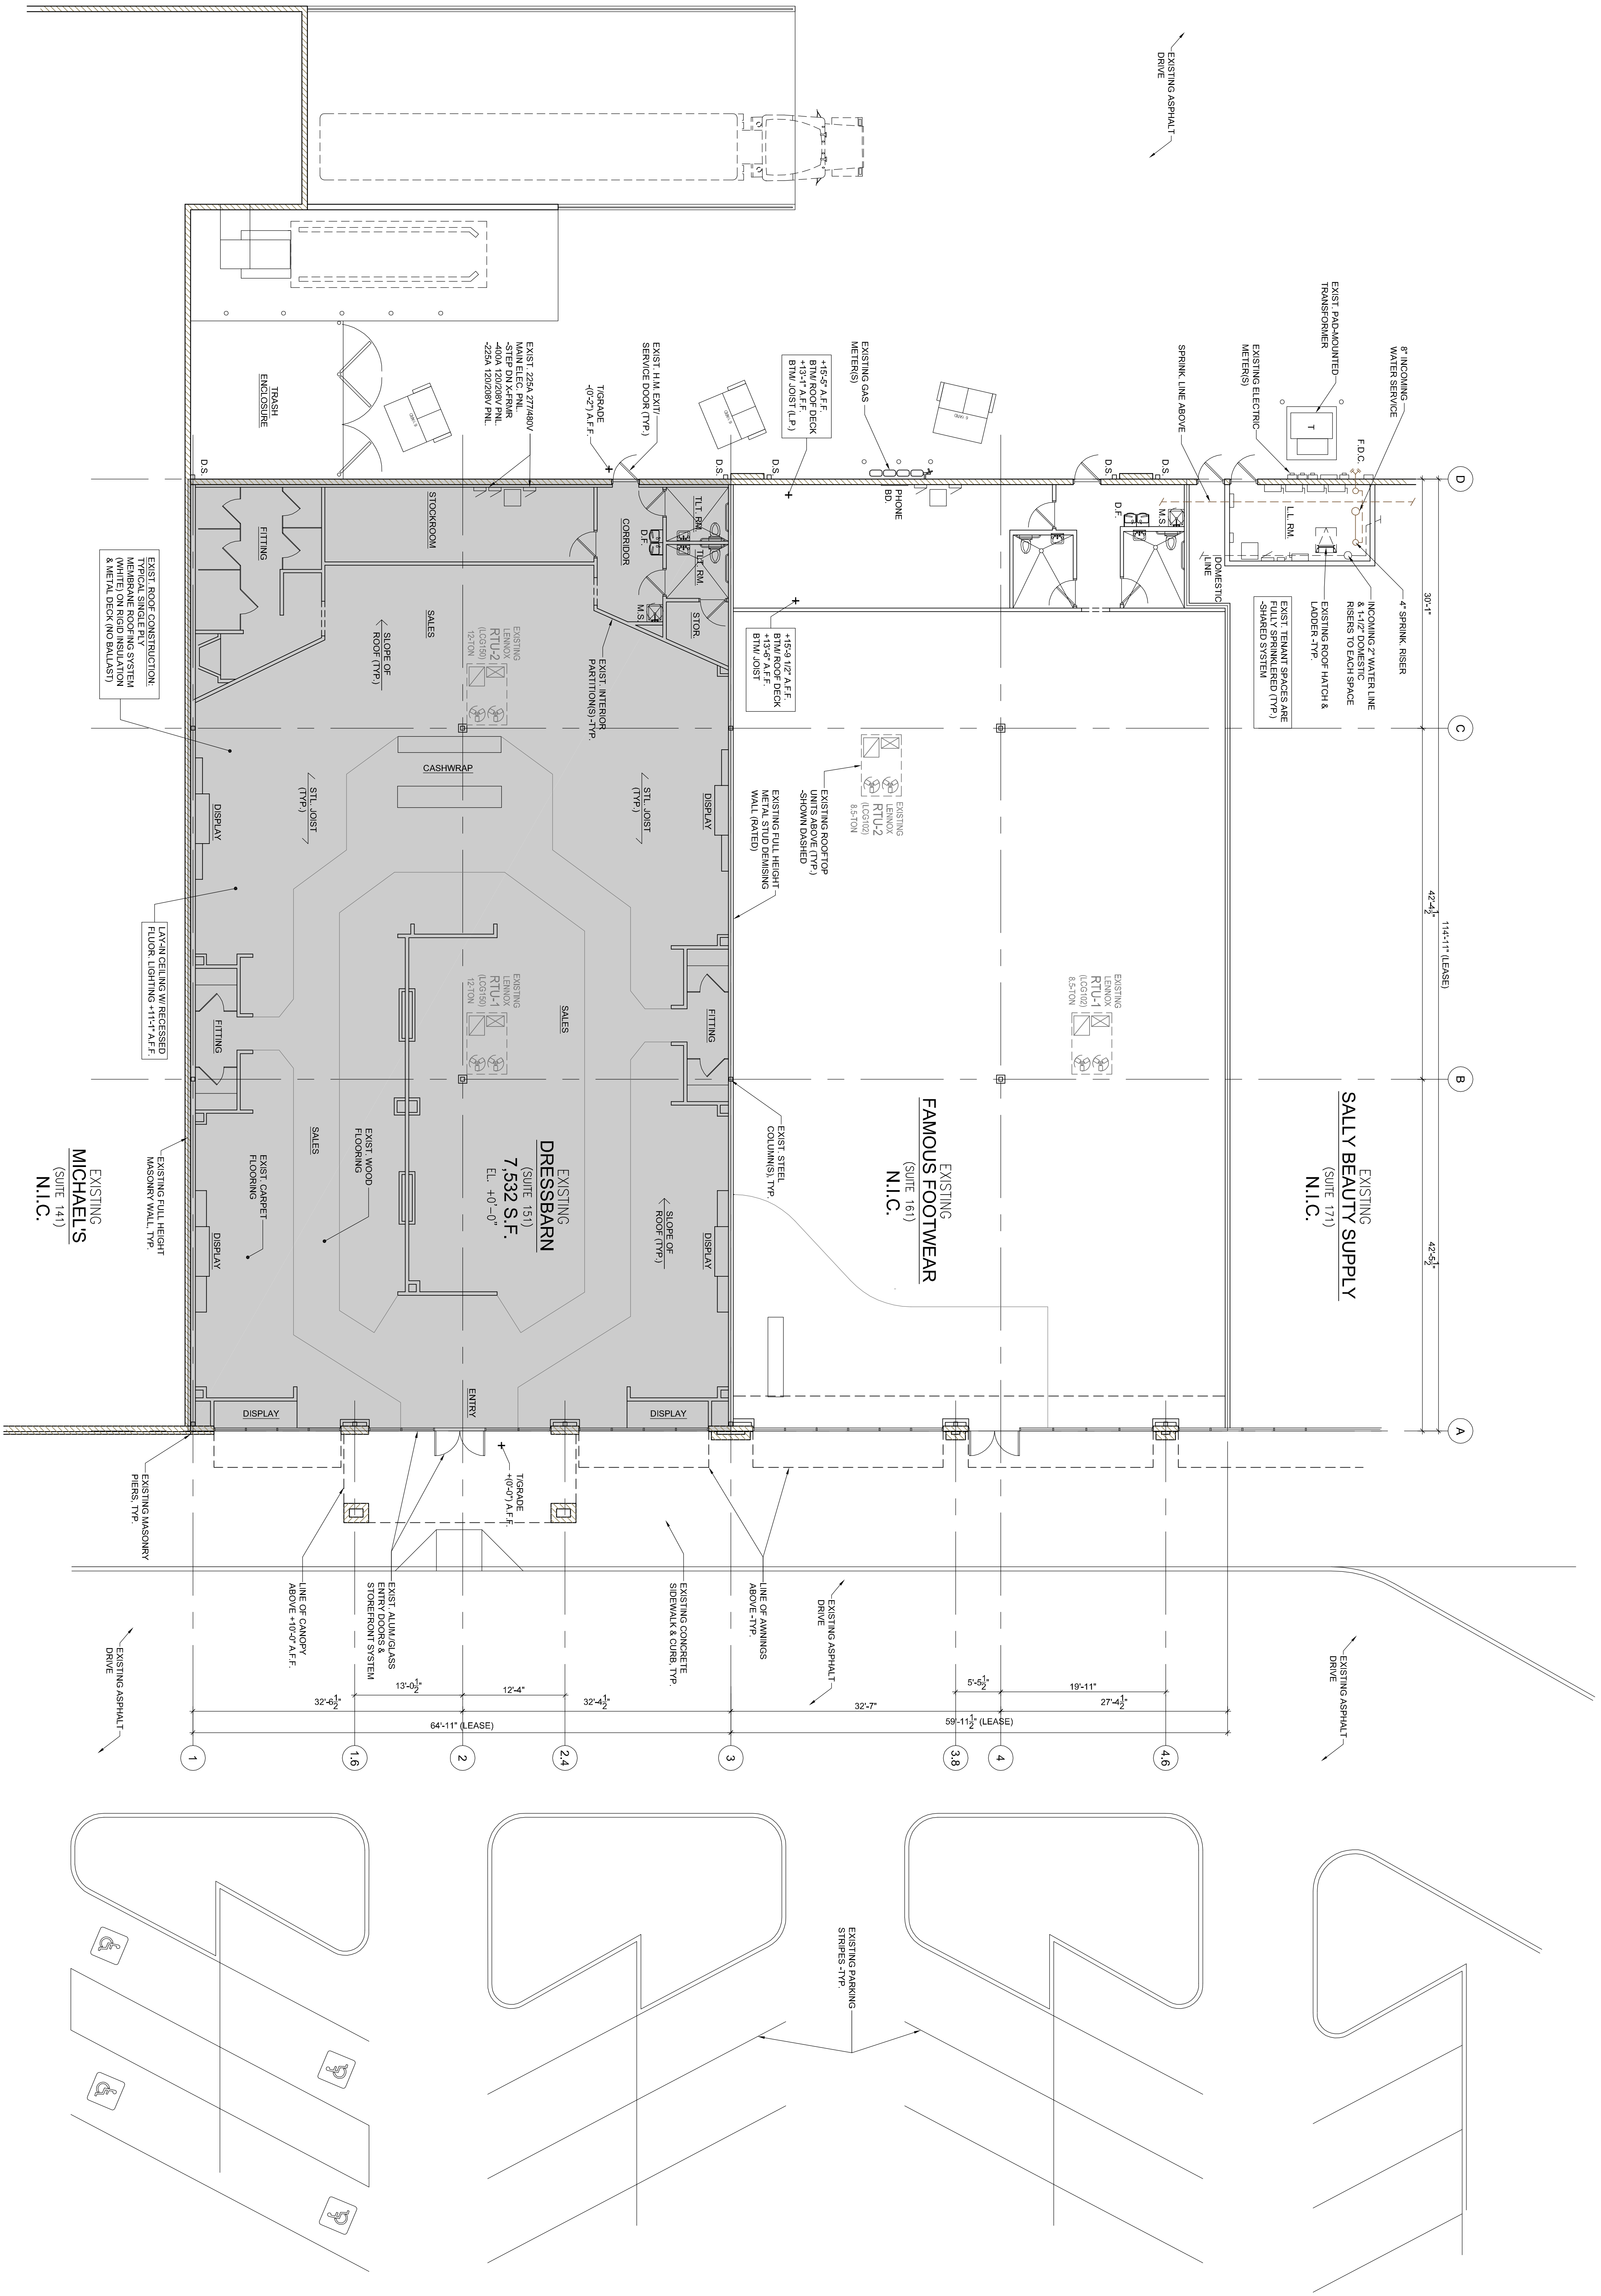

1 AS-BUILT FLOOR PLAN
SCALE: 1/8"=1'-0"

