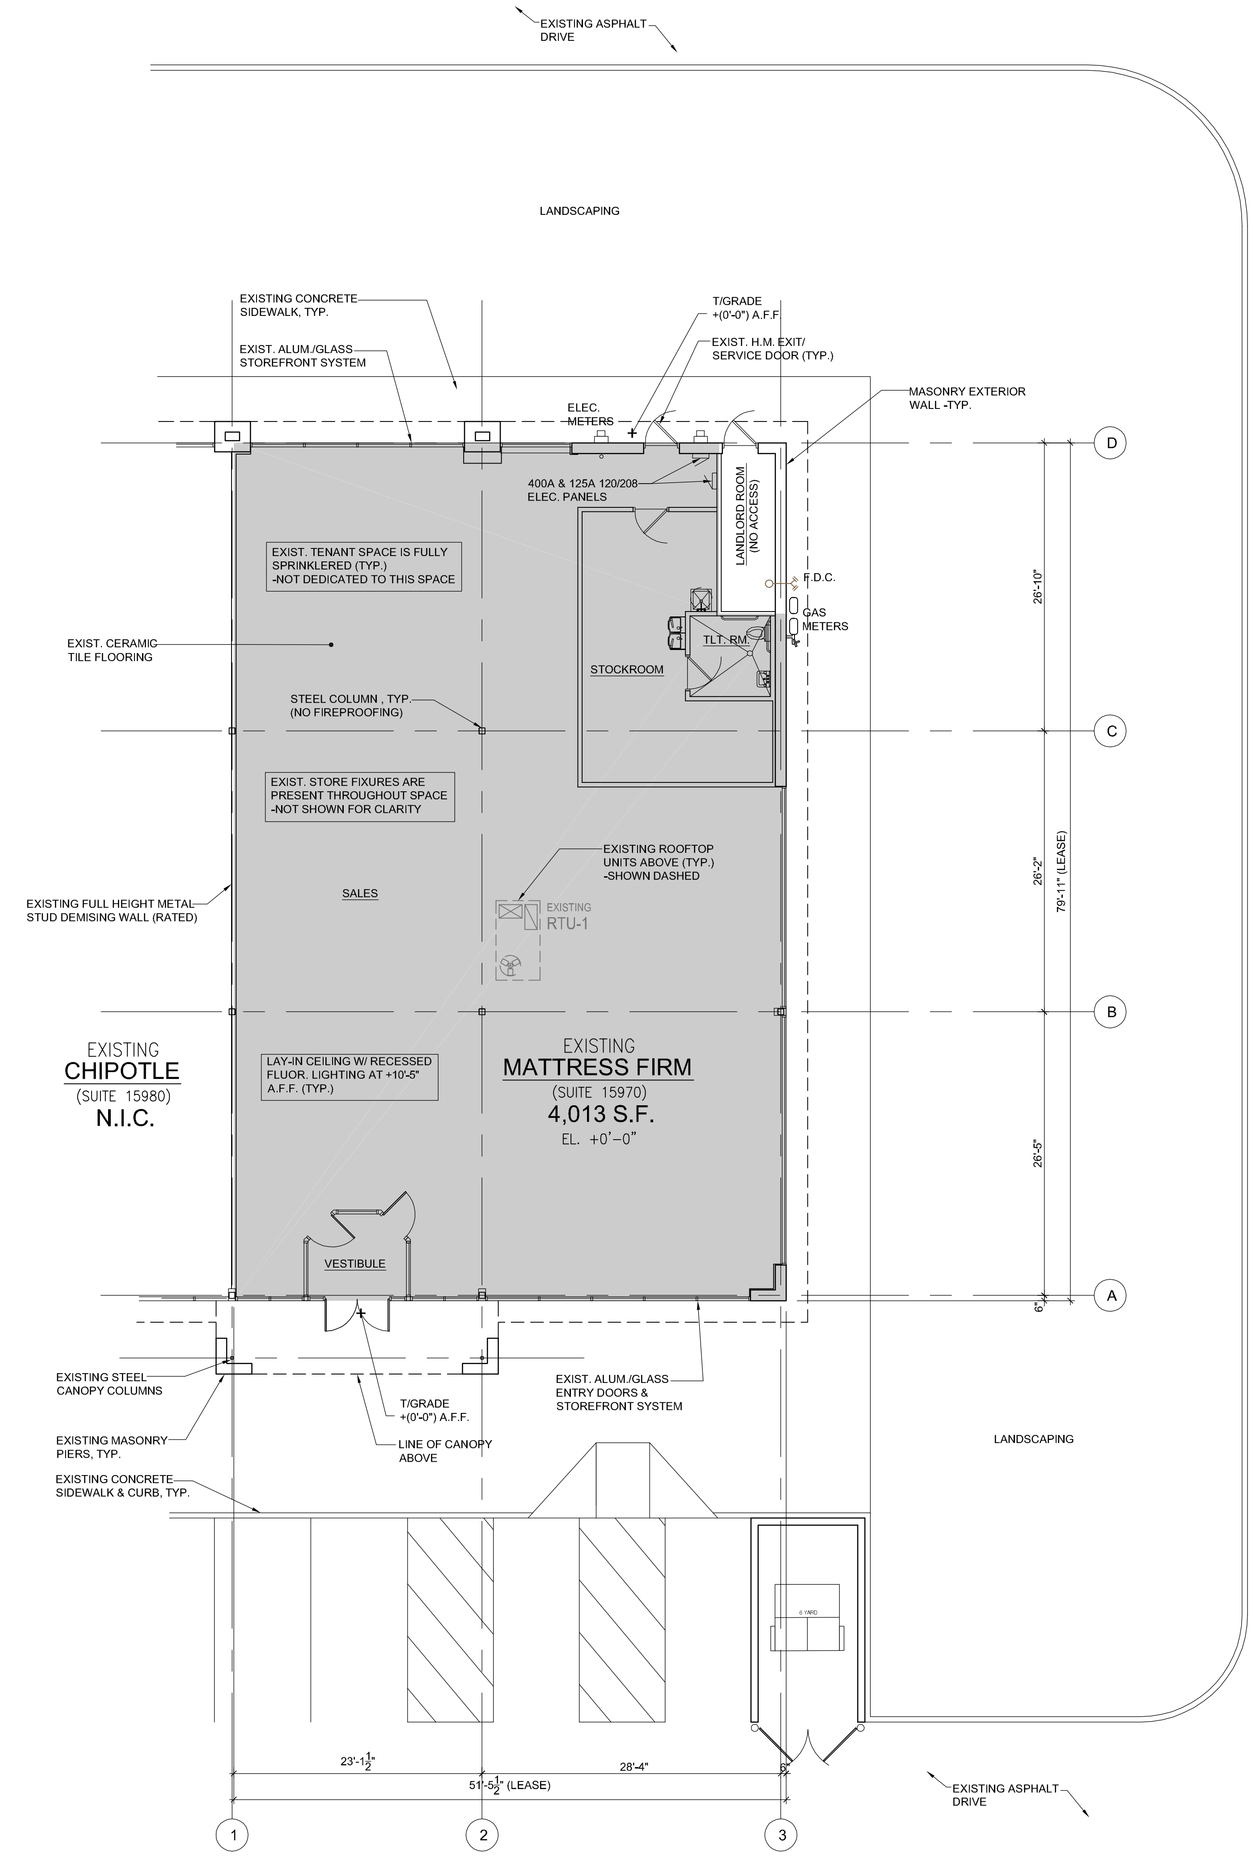

1 AS1.0 **AS-BUILT FLOOR PLAN**
SCALE: 1/8"=1'-0"

N

KEY PLAN

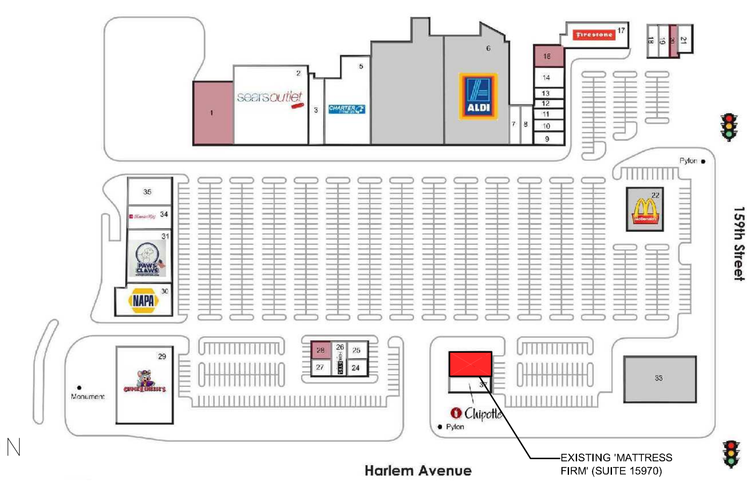

PFDA ARCHITECTS, INC.
2803 BUTTERFIELD RD.
SUITE 340
OAK BROOK, IL 60523
TEL: (312) 795-1245
FAX: (312) 795-6123

OWNER:

IRC RETAIL CENTERS
814 COMMERCE DRIVE
SUITE 300
OAK BROOK, IL 60523

PROJECT:

AS-BUILT
FLOOR PLANS

PARK CENTER
SW CORNER OF
159TH STREET &
HARLEM AVENUE
TINLEY PARK, IL

SHEET TITLE:
AS-BUILT
FLOOR PLAN

NO.	DATE	DESCRIPTION
	03.19.18	FOR REVIEW

COPYRIGHT - PFDA, INCORPORATED
ALL DRAWN AND WRITTEN INFORMATION APPEARING HEREIN SHALL NOT BE DUPLICATED, DISCLOSED OR OTHERWISE WITHOUT WRITTEN CONSENT.

DRAWN BY: | CHECKED BY:

SHEET:

AS1.0

JOB NO. 18025